

MISSISSIPPI DEPARTMENT OF NATURAL RESOURCES

Bureau of Land and Water Resources

Southport Mall

P.O. Box 10631

Jackson, Mississippi 39209

WATER WELL DRILLERS LOG

CODED

Sunflower  
D 65  
4/15/82

#2

BUTANE GAS CO. OF GREENWOOD  
 POST OFFICE BOX 147

Sunflower

4-15 1982  
 date well completed

GREENWOOD, MISS. 39090 county well located

LANDOWNER:	description of formations encountered	from	to
<u>Bubba Sharden</u>	<u>Sand</u>	<u>0</u>	<u>10</u>
<u>Drew Ma.</u>	<u>Clay</u>	<u>10</u>	<u>30</u>
(mailing address)	<u>gravel</u>	<u>30</u>	<u>60</u>
WELL LOCATION:	<u>Sand + gravel</u>	<u>60</u>	<u>93</u>
sec. <u>29</u> T <u>23</u> N			
R. <u>3</u> E			
<u>1/2</u> miles <u>N</u> of <u>Drew</u>	<u>hit large log</u>	<u>75</u>	<u>85</u>
(distance) (direction) (nearest town)			
WELL PURPOSE: <u>irrigation</u>			
(home, irrigation, municipal, industrial)			
WELL COMPLETION DATA:			
(1) diameter (inches) <u>16"</u>			
(2) total depth (feet) <u>93</u>			
(3) static water level (feet) <u>15</u> <sup>below</sup> <sub>above</sub> top of ground.			
(4) casing <u>Steel</u> , <u>53'</u>			
(material) (depth)			
<u>16</u> if telescope see back:			
(size)			
(5) screen <u>40</u> , <u>53'</u>			
(length) (depth to top)			
<u>76</u> , <u>Steel</u>			
(size) (material)			
(6) pump <u>150</u> , <u>1500</u>			
(HP) (yield gpm)			
<u>Diesel</u>			
(type power)			
(7) electric log <u>No</u>			
(yes or no)			
<u>No</u>			
(organization running log)			
(8) how well bottom plugged			
<u>Steel plate</u>			
DRILLERS REMARKS:			
<u>Charles Rowles</u>			


DEPT. OF NATURAL RESOURCES  
 BUREAU OF LAND & WATER RESOURCES

MAY 10 1982

RECEIVED

If well telescopes please sketch and show depths.

GROUND LEVEL

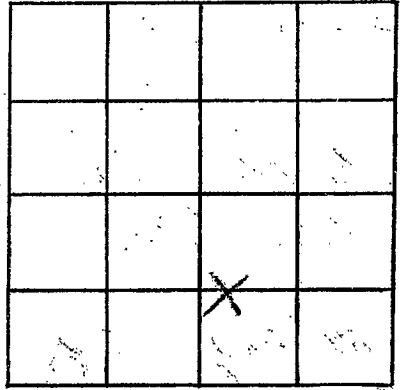

SECTION 29

Please indicate well location X.

ADDITIONAL INFORMATION

If more than one screen, show locations of each on sketch.