

MISSISSIPPI DEPARTMENT OF NATURAL RESOURCES

Bureau of Land and Water Resources

Southport Mall

P.O. Box 10631

Jackson, Mississippi 39209

BUTANE WATER WELL DRILLERS LOG

POST OFFICE BOX 1135

GREENWOOD, MISS. 38930

CODED

Sunflower  
D 66  
4/16/82

4-16-1982 date well completed      Sunflower firm name      county well located


LANDOWNER:	description of formations encountered	from	to
<u>Bubba Skurden</u>	<u>clay</u>	<u>0</u>	<u>20</u>
<u>Drew Ms.</u> (mailing address)	<u>sand</u>	<u>20</u>	<u>40</u>
	<u>fine gravel</u>	<u>40</u>	<u>103</u>
<b>WELL LOCATION:</b>			
sec. <u>32</u> T. <u>23</u> N. R. <u>3</u> E. <u>14</u> miles <u>N</u> of <u>Drew</u> (distance) (direction) (nearest town)			
<b>WELL PURPOSE:</b> <u>irrigation</u> (home, irrigation, municipal, industrial)			
<b>WELL COMPLETION DATA:</b>			
(1) diameter (inches) <u>16"</u>			
(2) total depth (feet) <u>103</u>			
(3) static water level (feet) <u>18</u> <u>below</u> above top of ground.			
(4) casing <u>Steel</u> , <u>63'</u> (material) (depth)			
<u>16</u> if telescope see back. (size)			
(5) screen <u>40</u> , <u>63'</u> (length) (depth to top)			
<u>16</u> <u>steel</u> (size) (material)			
(6) pump <u>150</u> <u>1500</u> (HP) (yield gpm)			
<u>Diesel</u> (type power)			
(7) electric log <u>No</u> (yes or no)			
<u>No</u> (organization running log)			
(8) how well bottom plugged <u>steel plate</u>			
<b>DRILLERS REMARKS:</b> <u>Carles R. Brown</u>			

DEPT. OF NATURAL RESOURCES  
BUREAU OF LAND & WATER RESOURCES

MAY 10 1982  
RECEIVED

If well telescopes please sketch and show depths.

GROUND LEVEL

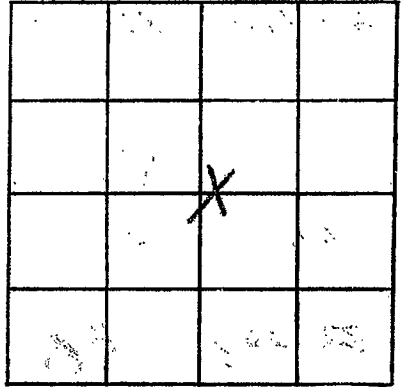

SECTION 32

Please indicate well location X.

ADDITIONAL INFORMATION

If more than one screen, show locations of each on sketch.