

**MISSISSIPPI DEPARTMENT OF NATURAL RESOURCES**  
**Bureau of Land and Water Resources**  
 Southport Mall  
 P.O. Box 10631  
 Jackson, Mississippi 39209  
**WATER WELL DRILLERS LOG**

**CODED**

Sunflower  
D 69  
5/18/82

date well completed 5/18/82 Dyer Well firm name Sunflower county well located

LANDOWNER: Ashton Farm

description of formations encountered	from	to

(mailing address)

<u>Clay</u>	<u>0</u>	<u>46</u>
<u>Sand &amp; Gravel</u>	<u>46</u>	<u>103</u>

WELL LOCATION:  
 sec 25 T 23 N R 3 E  
3 1/2 miles NE of Drew  
 (distance) (direction) (nearest town)

WELL PURPOSE:  
 (home irrigation, municipal, industrial)

WELL COMPLETION DATA:

- (1) diameter (inches) 16 1/2
- (2) total depth (feet) 103
- (3) static water level (feet) 14 below above top of ground.
- (4) casing Steel, 80 63  
 (material) (depth)  
12 1/2 if telescope see back.  
 (size)
- (5) screen 40, 63  
 (length) (depth to top)  
16, Mild steel  
 (size) (material)
- (6) pump 100 1200  
 (HP) (yield gpm)  
diesel  
 (type power)
- (7) electric log no  
 (yes or no)

(organization running log)

(8) how well bottom plugged plate


DRILLERS REMARKS:

DEPT. OF NATURAL RESOURCES  
 BUREAU OF LAND & WATER RESOURCES

SEP 30 1982  
**RECEIVED**

If well telescopes please sketch and show depths.

GROUND LEVEL

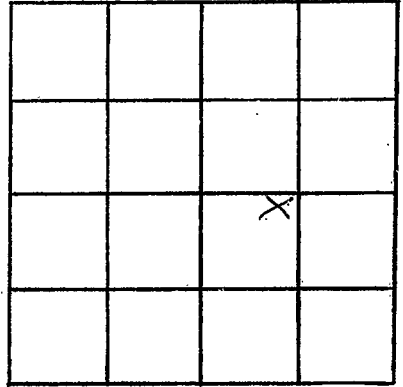

SECTION 25

Please indicate well location X.

ADDITIONAL INFORMATION

If more than one screen,  
show locations of each on sketch.