

MISSISSIPPI DEPARTMENT OF NATURAL RESOURCES

Bureau of Land and Water Resources

Southport Mall

P.O. Box 10631

Jackson, Mississippi 39209

WATER WELL DRILLERS LOG

CODED

Sunflower
D 70
4/1/82

4-11 1982 Alger Well Sunflower
 date well completed firm name county well located

LANDOWNER: F.C. Manning

description of formations encountered from to

(mailing address)

Clay	0	20
Fine Sand	20	36
Sand	36	48
Sand & Gravel	48	70
Sand	70	78
Sand & Gravel	78	113

WELL LOCATION:

sec 36 T 23 N R 3 E
S W
5 miles W of Drew
 (distance) (direction) (nearest town)

WELL PURPOSE:

(home, irrigation, municipal, industrial)

WELL COMPLETION DATA:

- (1) diameter (inches) 16
- (2) total depth (feet) 113
- (3) static water level (feet) 18 below above top of ground.
- (4) casing steel, 73,
 (material) (depth)
16 if telescope see back.
 (size)
- (5) screen 40, 73
 (length) (depth to top)
16, well steel
 (size) (material)
- (6) pump 40, 2000
 (HP) (yield gpm)
electric
 (type power)
- (7) electric log no
 (yes or no)

(organization running log)

(8) how well bottom plugged plate


DRILLERS REMARKS:

DEPT. OF NATURAL RESOURCES
 BUREAU OF LAND & WATER RESOURCES

SEP 30 1982
 RECEIVED

If well telescopes please sketch and show depths.

GROUND LEVEL

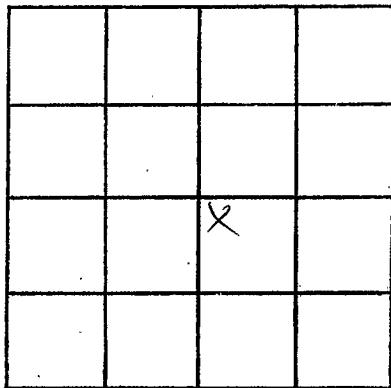

SECTION 36

Please indicate well location X.

ADDITIONAL INFORMATION

If more than one screen,
show locations of each on sketch.