

MISSISSIPPI DEPARTMENT OF NATURAL RESOURCES
 Bureau of Land and Water Resources
 Southport Mall
 P.O. Box 10631
 Jackson, Mississippi 39209
WATER WELL DRILLERS LOG

CODED

Senflower
D 71
411182

4-11 19 82 Oyster Well Senflower
 date well completed firm name county well located

LANDOWNER: David Woods
 (mailing address)

description of formations encountered	from	to
Clay	0	18
Shin sand	18	38
Sand	38	58
Sand & gravel	58	110

WELL LOCATION:
 sec 4 T 23 (N) R 3 E
5 miles N of Drew
 (distance) (direction) (nearest town)

WELL PURPOSE:
 (home, irrigation, municipal, industrial)

- WELL COMPLETION DATA:
- (1) diameter (inches) 16
 - (2) total depth (feet) 110
 - (3) static water level (feet) 18 below above top of ground.
 - (4) casing Steel 70
 (material) (depth)
 - 16 if telescope see back.
 (size)
 - (5) screen 40 20
 (length) (depth to top)
 - 16 Mild Steel
 (size) (material)
 - (6) pump 40 2000
 (HP) (yield gpm)
 - electric
 (type power)
 - (7) electric log no
 (yes or no)
 - (organization running log)
 - (8) how well bottom plugged plate

DRILLERS REMARKS:


DEPT. OF NATURAL RESOURCES
 BUREAU OF LAND & WATER RESOURCES

SEP 30 1982

RECEIVED

If well telescopes please sketch and show depths.

GROUND LEVEL

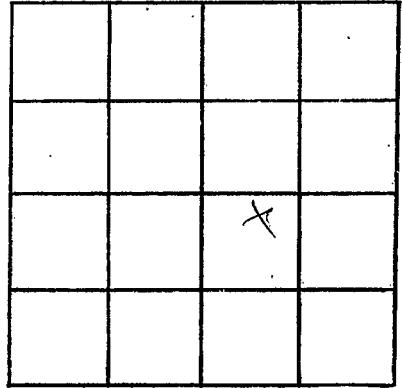

SECTION 4

Please indicate well location X.

ADDITIONAL INFORMATION

If more than one screen,
show locations of each on sketch.