

MISSISSIPPI DEPARTMENT OF NATURAL RESOURCES

Bureau of Land and Water Resources

Southport Mall

P.O. Box 10631

Jackson, Mississippi 39209
WATER WELL DRILLERS LOG

CODED

Amflow
D 72
8/24/82

8-24 1982 date well completed Deep Well firm name Amflow county well located

LANDOWNER: H T MILLER

(mailing address)

WELL LOCATION:
sec. 34 T 23 N R 3 E
1 1/2 miles E of Green
(distance) (direction) (nearest town)

description of formations encountered	from	to
Clay	0	8
Fine B. Sand	8	38
Fine Sand	38	56
Sand + Gravel	56	62
Fine Sand	62	80
Sand + Gravel	80	106

WELL PURPOSE:
(home, irrigation, municipal, industrial)

WELL COMPLETION DATA:

(1) diameter (inches) 16

(2) total depth (feet) 106

(3) static water level (feet) 18 below above top of ground.

(4) casing Steel 40-66
(material) (depth)
16 If telescope see back.
(size)

(5) screen 40 40-66
(length) (depth to top)
16 Mild Steel
(size) (material)

(6) pump 80 1200
(HP) (yield gpm)
diesel
(type power)

(7) electric log No
(yes or no)
No
(organization running log)

(8) how well bottom plugged plate

DEPT. OF NATURAL RESOURCES
BUREAU OF LAND & WATER RESOURCES


FEB 3 1983

RECEIVED

DRILLERS REMARKS:

If well telescopes please sketch and show depths.

GROUND LEVEL

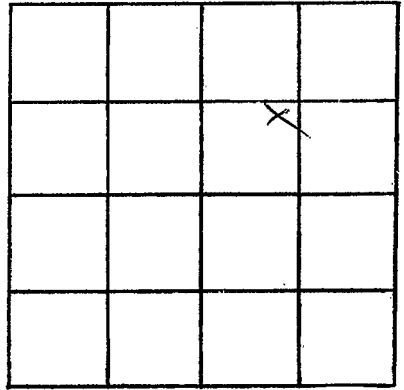

SECTION 34

Please indicate well location X.

ADDITIONAL INFORMATION

If more than one screen, show locations of each on sketch.