

MISSISSIPPI DEPARTMENT OF NATURAL RESOURCES

Bureau of Land and Water Resources

Southport Mall

P.O. Box 10631

Jackson, Mississippi 39209

WATER WELL DRILLERS LOG

CODED


*Sunflower*  
D 73  
8/25/82

825 1982 date well completed      Super Well firm name      Sunflower county well located

LANDOWNER: <i>M. J. Miller</i>	description of formations encountered	from	to
(mailing address)	<i>Clay</i>	<i>0</i>	<i>16</i>
WELL LOCATION: sec <i>27</i> T <i>23</i> (N) R <i>3</i> E <i>2</i> miles <i>E</i> of <i>Drew</i> (distance) (direction) (nearest town)	<i>fine sand</i>	<i>16</i>	<i>28</i>
WELL PURPOSE: (home, irrigation, municipal, industrial)	<i>Sand &amp; gravel</i>	<i>28</i>	<i>104</i>
WELL COMPLETION DATA: (1) diameter (inches) <i>16</i> (2) total depth (feet) <i>104</i> (3) static water level (feet) <i>18'</i> below above top of ground. (4) casing <i>Steel</i> , <i>64</i> , (material) (depth) <i>16</i> if telescope see back. (size) (5) screen <i>40</i> , <i>40</i> (length) (depth to top) <i>16</i> , <i>med steel</i> (size) (material) (6) pump <i>80</i> , <i>1200</i> (HP) (yield gpm) <i>diesel</i> (type power) (7) electric log <i>No</i> (yes or no) <i>no</i> (organization running log) (8) how well bottom plugged <i>plate</i>	<p>DEPT. OF NATURAL RESOURCES BUREAU OF LAND &amp; WATER RESOURCES</p> <p>FEB - 3 1983</p> <p>RECEIVED</p>		
DRILLERS REMARKS:			

If well telescopes please sketch and show depths.

GROUND LEVEL

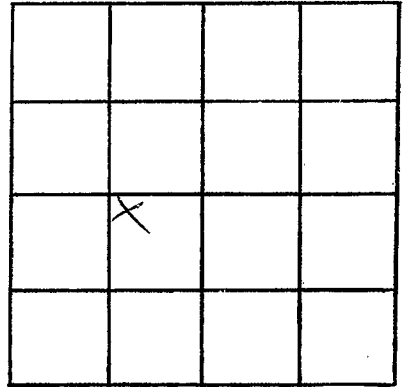

SECTION 27

Please indicate well location X.

ADDITIONAL INFORMATION

If more than one screen,  
show locations of each on sketch.