

MISSISSIPPI DEPARTMENT OF NATURAL RESOURCES

Bureau of Land and Water Resources

Southport Mall

P.O. Box 10631

Jackson, Mississippi 39209

WATER WELL DRILLERS LOG

CODED

Sunflower  
D 74  
8/24/82

19 19 date well completed

Dyer Well + Inc firm name

Sunflower Co county well located

LANDOWNER: Steve Shurden

description of formations encountered

from

to

(mailing address)

WELL LOCATION:

sec 35 T 23 (N) R 3 E  
3 1/2 miles NE of Drew  
(distance) (direction) (nearest town)

WELL PURPOSE:

(home, irrigation, municipal, industrial)

WELL COMPLETION DATA:

- (1) diameter (inches) 16"
- (2) total depth (feet) 118
- (3) static water level (feet) 22 below above top of ground.
- (4) casing steel, 78,  
(material) (depth)  
(size) if telescope see back.
- (5) screen 40', 40'  
(length) (depth to top)  
16, steel  
(size) (material)
- (6) pump 40 1800  
(HP) (yield gpm)  
diesel  
(type power)
- (7) electric log no  
(yes or no)  
no  
(organization running log)
- (8) how well bottom plugged plate

Clay	0	20
Fine Sand	20	38
Sand	38	70
Fine Sand	70	90
Sand + Gravel	90	118

DEPT. OF NATURAL RESOURCES  
BUREAU OF LAND & WATER RESOURCES


FEB - 3 1983

RECEIVED

DRILLERS REMARKS:

If well telescopes please sketch and show depths.

GROUND LEVEL

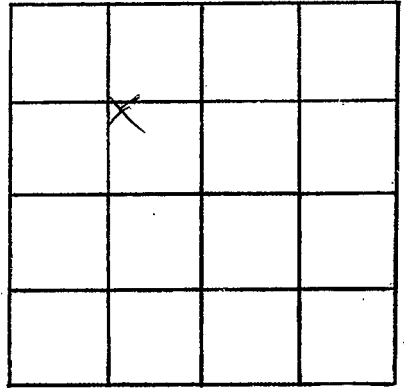

SECTION 25

Please indicate well location X.

ADDITIONAL INFORMATION

If more than one screen,  
show locations of each on sketch.