

MISSISSIPPI DEPARTMENT OF NATURAL RESOURCES

Bureau of Land and Water Resources

Southport Mall

P.O. Box 10631

Jackson, Mississippi 39209

WATER WELL DRILLERS LOG

CODED

SUNFLOWER

D 75

June 9 1984
date well completed

D. O. Well
firm name

Sunflower
county well located

LANDOWNER:

Iris Reed

Drew Iris

(mailing address)

description of formations encountered

from

to

700	0	6
fine sand	6	10
course sand + gravel	10	25
course sand	25	40
course sand + large gravel	40	118

WELL LOCATION:

sec. 8 T 23 N R 3 E
5 miles mostly of Drew
(distance) (direction) (nearest town)

WELL PURPOSE: Irrigation
(home, irrigation, municipal, industrial)

WELL COMPLETION DATA:

CODED

- (1) diameter (inches) 16"
- (2) total depth (feet) 118
- (3) static water level (feet) 26 below top of ground.
- (4) casing Steel (material), (depth) (size) If telescope see back.
- (5) screen 40' (length), (depth to top) 16" (size), steel (material)
- (6) pump 60 (HP) 3100 (yield gpm) Diesel (type power)
- (7) electric log 700 (yes or no)

(organization running log)

(8) how well bottom plugged Steel Plate

DRILLERS REMARKS:

DEPT. OF NATURAL RESOURCES
BUREAU OF LAND & WATER RESOURCES

JUN 28 1984

RECEIVED

If well telescopes please sketch and show depths.


GROUND LEVEL

Water level
26 ft

16"
Casing

4" x 16"
screen

If more than one screen,
show locations of each on sketch.

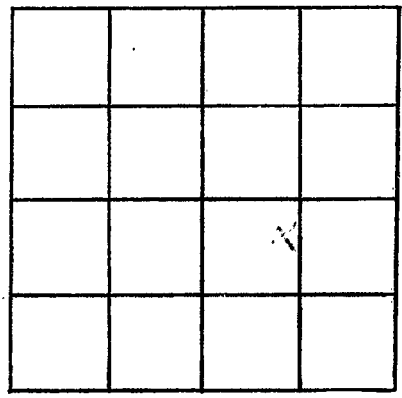

SECTION 8

Please indicate well location X.

ADDITIONAL INFORMATION

Lined area for additional information.