

MISSISSIPPI DEPARTMENT OF NATURAL RESOURCES

Bureau of Land and Water Resources

Southport Mall

P.O. Box 10631

Jackson, Mississippi 39209

WATER WELL DRILLERS LOG

BUTANE GAS COMPANY

CODEN

SUNFLOWER
D 76


8-30 1986
date well completed

OF GREENWOOD
well name

Sunflower
county well located

LANDOWNER:	description of formations encountered	from	to
Dr. Travis Richardson	CLAY	0	15
Rokeville, Miss. (mailing address)	FINE SAND	15	65
	SAND pea gravel	65	75
	gravel	75	105
<p>WELL LOCATION:</p> <p>sec. <u>20</u> T <u>23</u> N R <u>3</u> E S (W)</p> <p><u>2.4</u> miles <u>N</u> of <u>Drew</u> (distance) (direction) (nearest town)</p>			
<p>WELL PURPOSE: <u>298</u> (home, irrigation, municipal, industrial)</p>			
<p>WELL COMPLETION DATA:</p>			
<p>(1) diameter (inches) <u>16"</u></p>			
<p>(2) total depth (feet) <u>105</u></p>			
<p>(3) static water level (feet) <u>70</u> <u>below</u> above top of ground.</p>			
<p>(4) casing <u>Steel</u> / <u>65</u> (material) (depth)</p>			
<p><u>16"</u> if telescope see back. (size)</p>			
<p>(5) screen <u>40</u> / <u>65</u> (length) (depth to top)</p>			
<p><u>16"</u> / <u>Steel</u> (size) (material)</p>			
<p>(6) pump <u>60</u> / <u>2500</u> (HP) (yield gpm)</p>			
<p><u>Diesel</u> (type power)</p>			
<p>(7) electric log <u>NO</u> (yes or no)</p>			
<p>(organization running log)</p>			
<p>(8) how well bottom plugged: <u>Steel Plate</u></p>			
<p>DRILLERS REMARKS:</p>			

CODEN

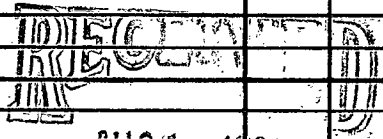


AUG 12 1986

Department of Natural Resources
Bureau of Land & Water Resources

If well telescopes please sketch and show depths.

GROUND LEVEL

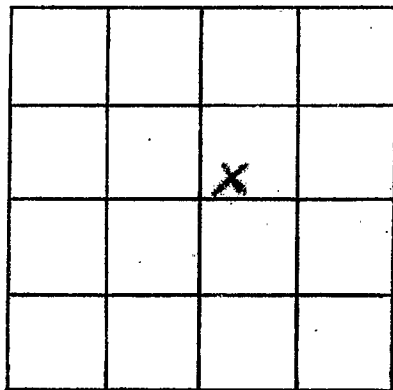

SECTION 20

Please indicate well location X.

ADDITIONAL INFORMATION

If more than one screen,
show locations of each on sketch.