

MISSISSIPPI DEPARTMENT OF NATURAL RESOURCES

Bureau of Land and Water Resources

Southport Mall

P.O. Box 10631

Jackson, Mississippi 39209

WATER WELL DRILLERS LOG

Sunflower
#MS-GW-06567
D 77

4-7 1987 *Oyeu Well, Inc* *Sunflower*
date well completed firm name county well located

LANDOWNER:	Description of formations encountered	from	to
<i>Gloria Belle Brittman</i> <i>(David Woods) Land Center</i> 1401 Garland Plainville, TX 79072 (mailing address)	Clay Fine Sand Sand + Gravel	0 28 78	28 78 105
WELL LOCATION:			
sec. <u>30</u> T <u>23</u> N R <u>3</u> E S W			
_____ miles _____ of <i>Wheeler</i> (distance) (direction) (nearest town)			
WELL PURPOSE: <i>Irrigation</i> (home, irrigation, municipal, industrial)			
WELL COMPLETION DATA:			
(1) diameter (inches) <u>16"</u>			
(2) total depth (feet) <u>105</u>			
(3) static water level (feet) _____ below top of ground. above			
(4) casing <u>Steel</u> (material) (depth) _____			
<u>16"</u> if telescope see back. (size)			
(5) screen <u>40'</u> (length) (depth to top) _____			
<u>16"</u> <u>Steel</u> (size) (material)			
(6) pump <u>2000</u> (HP) (yield gpm)			
_____ (type power)			
(7) electric log <u>No</u> (yes or no)			
_____ (organization running log)			
(8) how well bottom plugged <u>Plate</u>			

RECEIVED
MAY 1 1987


APR 17 1987

Department of Natural Resources
Bureau of Land & Water Resources

DRILLERS REMARKS:
(Well Permit #MS-GW-06567)

If well telescopes please sketch and show depths.

GROUND LEVEL

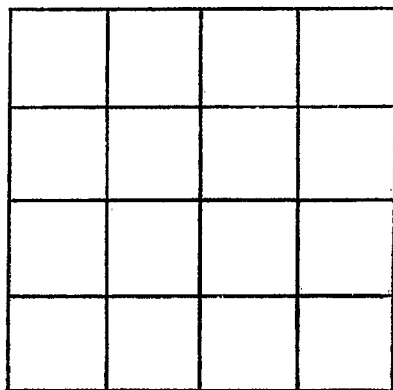

SECTION _____

Please indicate well location X.

ADDITIONAL INFORMATION

If more than one screen,
show locations of each on sketch.