County: SUNFLOWER
Permit #60 41695 Irrigation Equipment
Driller:

State Well Report

Part 1

Mississippi Department of Environmental Quality
Office of Land and Water Resources
P.O. Box 10631
Jackson, MS 39289-0631
(601)961-5210
(601)354-6938 (fax)

For Office Use Only:
Aquifer:
Well #:
L. S. Elevation:
E-log #:

State Law requires that this report be prepared by the driller in detail and filed with the Department within 30 days of completion of drilling of the well.

30 days of completion of drilling of the well.		
Well Owner Information	Well Location	
Owner Name Wayne Parks	Latitude: 'Longitude: 'Longitu	
Mailing Address: 44 Schillings Road	Method of Lat/Long (circle one): Conventional Survey,	
•	USGS quad, Hand-held GPS, Survey-grade GPS	
Drew MS 38737	<u>SE 1/4 SW 1/4 Sec 3 / Twn 23 N Rng 3 W</u>	
City State Zip Code 662-745-2608	Distance Direction Nearest Town 2 Miles West of Drew	
Telephone No. ()		
Well I	Data	
Purpose of Well (circle one) Home Industrial Public Supply	(Irrigation Fish Culture Other:	
Date well drilling started: 3-27-07 Date w	well drilling completed: 3-27-07	
If flowing, method of flow regulation: Valve Other (d	escribe)	
Static Water Level:feet above or below (circle one) l	and surface Date measured:	
Method of Measurement (circle one) steel tape electric tape	air line other:	
Hole depth: 109 Well depth: 109	Well grouted to a depth offeet	
Type of grout (circle one): Cement Bentonite Mix		
Casing length: 67 feet Casing diameter. 10	inches Type of casing: PVC 160	
Screen length: 40 feet Screen diameter: 10	inches Type of screen: PVC160	
Screen slot size: ,050 inches Setting depth: From	70 feet to 109 feet	
Type of completion (circle all applicable): Grayel packed Under	reamed Telescoped Open hole Natural Development	
Other (describe):		
Top of lap pipe or reduction in casing:feet. If tel	escoped or more than one screen, describe on back of page	
Logs run (circle all applicable): Vo log run Electric Gamma Ray	Density Sonic Neutron Other:	
Name of organization running log(s):	_	
I certify that the well was drilled, constructed, and completed in accordance with all applicable requirements of the Mississippi		
Department of Environmental Quality and/or the Mississippi Department of Health regulations and state laws.		
Irrigation Equipment Inc. Patrick M. Chism 0695	DHM	
	Tahil III	
Print Name of Water Well Contractor and License No.	Signature of Water Well Contractor	

*Note: No pump was installed.

RECEIVED

APR 2 0 2007


BY: OLWA

Ground Level

Description of Formations Encountered	From	To
DAV	0	37
Fine Sand Coarse sand medium sand + gravel Clay	38	47
Course SAAA	48	67
madius sail a gravel	1/2	707
mezium sance jiavei	100	109
Clay	100	101
	_	
		-
		$ldsymbol{ldsymbol{ldsymbol{eta}}}$
		<u> </u>
		Ţ
		+
		┼──┤
		+-+
		<u> </u>
		$oldsymbol{ol}}}}}}}}}}}}}}}}}}$
	_	1
		+
		1
		<u> </u>

If more than one screen, show location of each on sketch

Sketch the property layout and include the following: 1) the well location; 2) any permanent structures on the property that may aid in locating the well; 3) any roads, power lines, or other items that may aid in locating the property and the well; 4) indicate direction.

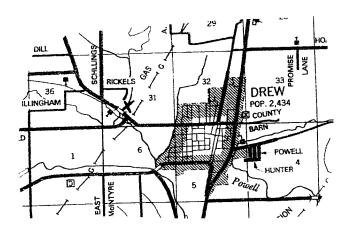

andowner Name:	
andowner name.	

Signature of Water Well Contractor