	State W	ell Report		
\ \ \ \ \ \ \ \ \ \ \ \ \ \ \ \ \ \ \		art 1	For Office Use Only:	
county: Sunflower		att i t of Environmental Quality	Aquifer:	
Permit #:	,	nd Water Resources	Well #: D-115	
Irrigation Equipment	1	Box 10631	Well #:	
Driller:		IS 39289-0631	L. S. Elevation:	
Date drilling completed: 4-4-07		961-5210	L. U. Elevation	
Date diming compresses.	, ,	4-6938 (fax)	E-log #:	
<u> </u>	, ,	, ,		
State Law requires that this repo 30 days of completion of drilling				
Well Owner Informa		Wel	Location	
Owner Name Stanley Lumb	er Products	Latitude: <u>33 ° 50 '43</u>	" Longitude: <u>90° 29 ' 01</u> "	
Mailing Address: CO Dav.d			ne): Conventional Survey,	
Box 271	•	<u> </u>	GPS, Survey-grade GPS	
	ms 39367	NW 1/4 SW 1/4 Sec 23	T_{wn} 23 N R_{ng} 3W	
waynesboro City 1-800-851-	te Zip Code	Distance Direction	Nearest Town	
1-800-851-	6336	Distance Direction Miles NE	of Drew	
Telephone No. ()	-			
·	Well			
	Well 1	Data		
Purpose of Well (circle one) Home Ind	lustrial Public Supply	Irrigation Fish Culture	Other:	
Date well drilling started: 4-4-6			1-4-07	
Date well drilling started:	Date v	well drilling completed:		
If flowing, method of flow regulation: Valve Other (describe)				
It howing, method of flow regulation: valve Other (describe)				
Static Water Level: 42 feet above on below (circle one) land surface Date measured: 4-4-07				
Method of Measurement (circle one) steel tap electric tape air line other:				
Hole depth: 125 Well de	pth: 125	Well grouted to a depth of _		
Type of grout (circle one): Cement	Bentonite Mix		RECEIVE	
Type of grout (circle one): Cement Casing length: 45 feet Casin Screen length: 40 feet Screen	ng diameter: 10	inches Type of casing: _	APP 25	
		inches Type of screen: _	PVC1199	
Screen slot size:	Setting depth: From _	86 feet to	feet " ULWF	
Type of completion (circle all applicable):	Gravel packed Under	rreamed Telescoped Oper	hole Natural Development	
	Other (describe):	and the state of t		
Top of lap pipe or reduction in casing:	feet. If te	elescoped or more than one sci	reen, describe on back of page	
Logs run (circle all applicable): (No log ru	Electric Gamma Ray	Density Sonic Neutron	Other:	
Name of organization running log(s):	wated and completed in	accordance with all annicable	e requirements of the Mississippi	

Department of Environmental Quality and/or the Mississippi Department of Health regulations and state laws.

Signature of Water Well Contractor


Irrigation Equipment Inc. Patrick M. Chism 0695

Print Name of Water Well Contractor and License No.

Ground Level

Description of Formations Encountered	From	То
	10	25
clay Fine Sand medium Sand Coarse Sand Coarse sand + gravel Gravel	26	45
medium sand	46	65
Coarse sand	64	75
COArse sand + grave!	96	105
Gravel	106	
		1
		+
		1
	 	1-1
		1
		1
		\perp
		\bot

If more than one screen, show location of each on sketch

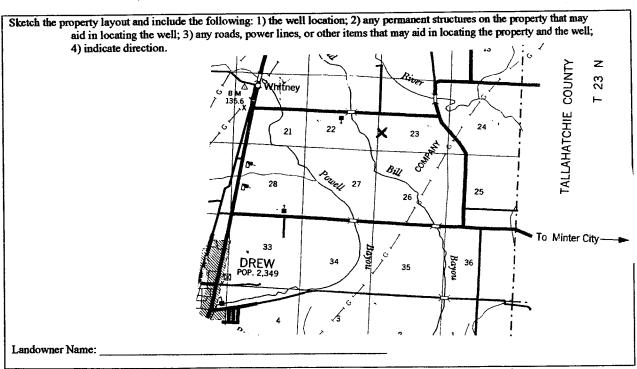

Signature of Water Well Contractor

STATE WELL REPORT

Permit#: Irrigation Equipment 4-4-07

Part 2

Pump Installer's Completion Report
Mississippi Department of Environmental Quality
Office of Land and Water Resources P.O. Box 10631 Jackson, MS 39289-0631

For Office Use Only:			
Aquifer:			
Well#:	D-115		
Elevation	n:		

Date completed: 1-7-01		(601)961-5210 (601)354-6938 (fax)		Elevation:							
This report should be prepared by the		` '	L								
installation of pump.			- open enten								
Well Owner Information		Well Location									
Owner Name: Stanley Lumb	er roducts	Latitude: Longitude:									
Mailing Address: Clo Dawid Stanley BOX 271 Waynesboro ms 39367 City State Zip Code		Method of Lat/Long (circle one): Conventional Survey, USGS quad, Hand-held GPS, Survey-grade GPS 14 14 Sec 23 Twn 23 N Rng 3 W									
						City* State	Zip Code	Distance I	Direction	Nearest Tov	n l
						Telephone No. ()		5 Miles NE of Drew			
D			-								
Pump Type Circle one		Power Type Circle one									
Air Lift Jet	Submersible	Diesel Engine	Gasoline E	ngine	Natural Gas						
Bucket Piston	Turbine	Electric Motor	Hand		Tractor PTO						
Centrifugal Rotary	Flowing Well	Windmill	Other (spe	cify):							
Other (specify):		Horse Power Rating	g of Motor:	10							
Date Pump Installed: 4-4-07		Setting Depth:	70	RE	EEIVED						
Rated Pump Capacity: 500	Gallons Per Minute	Number of Stages:		AI	PR 27 2007						
D			hod of Measu	RV							
Pump Test Data Date Well Tested:		Meti	hod of Measur Circle		MULWR						
Static Water Level (A): Feet F	1	Air Line El	ectric Measuri	ng Line	Steel Tape						
Pumping Water Level (B):Feet B	l	Other (specify):	· · · · · · · · · · · · · · · · · · ·								
Drawdown [(B) - (A)]:Feet Below Land Surface		For flowing well, m	easured shut is	n head:	fect						
Test Pumping Rate:Gallons Per Minute		Well yieldedGPM with a drawdown of									
Duration of Pump Test (minimum 4 hours):hours		feet afterhours of pumping									
I HEREBY CERTIFY that the above stateme		my knowledge.	1								
Datrick M Chiam 060	11 L	117711	A 1/		1						

I HEREBY CERTIFY that the above statements are true to the best	t of my/Chrowledge.	
Patrick M. Chism 0695	Patrick M Cha	
Print Name of Pump Installer and License No. (if applicable)	Signature of Pump Installer	