

State Well Report
Part I

Mississippi Department of Environmental Quality
Office of Land and Water Resources
P.O. Box 10631
Jackson, MS 39289-0631
(601)961-5210
(601)354-6938 (fax)

County: Sunflower
Permit #: GW49320
Irrigation Equipment
Driller: _____
Date drilling completed: 8-7-07

For Office Use Only:
Aquifer: _____
Well #: D-118
L. S. Elevation: _____
E-log #: _____

State Law requires that this report be prepared by the driller in detail and filed with the Department within 30 days of completion of drilling of the well.

Well Owner Information
Owner Name: Robert Ed Connell
Mailing Address: 1007 Farmers St.
Cleveland Ms. 38732
City State Zip Code
Telephone No. (662) 515-4438
Well Location: 27 08
Latitude: 33° 51' 55" N Longitude: 90° 26' 31.7" W
Method of Lat/Long (circle one): Conventional Survey
USGS quad, Hand-held GPS, Survey-grade GPS
SE 1/4 NE 1/4 Sec 13 Twn 23N Rng 3W
Distance: 5 Miles Direction: NE of Nearest Town: Drew

Well Data
Purpose of Well (circle one) Home Industrial Public Supply Irrigation Fish Culture Other: Replacement
Date well drilling started: 8-7-07 Date well drilling completed: 8-7-07
If flowing, method of flow regulation: Valve _____ Other (describe) _____
Static Water Level: 47 feet above or below (circle one) land surface Date measured: 8-8-07
Method of Measurement (circle one) steel tape electric tape air line other: _____
Hole depth: 126 Well depth: 126 Well grouted to a depth of 10 feet
Type of grout (circle one): Cement Bentonite Mix
Casing length: 86 feet Casing diameter: 16 inches Type of casing: PVC
Screen length: 40 feet Screen diameter: 16 inches Type of screen: PVC
Screen slot size: .050 inches Setting depth: From 87 feet to 126 feet
Type of completion (circle all applicable): Gravel packed Underreamed Telescoped Open hole Natural Development
Other (describe): _____
Top of lap pipe or reduction in casing: _____ feet. If telescoped or more than one screen, describe on back of page
Logs run (circle all applicable): No log run Electric Gamma Ray Density Sonic Neutron Other: _____
Name of organization running log(s): _____

I certify that the well was drilled, constructed, and completed in accordance with all applicable requirements of the Mississippi Department of Environmental Quality and/or the Mississippi Department of Health regulations and state laws.

Irrigation Equipment Inc.
Patrick M. Chism 0695

Patrick M. Chism
Signature of Water Well Contractor

Print Name of Water Well Contractor and License No.

Signature of Water Well Contractor

RECEIVED

AUG 28 2007
BY: OLWR

D-118

If well telescopes please sketch below and show depths.


Ground Level

Description of Formations Encountered	From	To
Clay	0	33
Fine Sand + Gravel	34	48
Medium Sand + Gravel	49	126

If more than one screen, show location of each on sketch

Sketch the property layout and include the following: 1) the well location; 2) any permanent structures on the property that may aid in locating the well; 3) any roads, power lines, or other items that may aid in locating the property and the well; 4) indicate direction.

Landowner Name: Robert Ed Connell

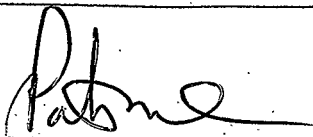

Signature of Water Well Contractor

RECEIVED
AUG 28 2007
BY: OLWR

[The page contains extremely faint and illegible text, likely bleed-through from the reverse side of the document. The text is arranged in several columns and paragraphs, but no specific words or phrases can be discerned.]

STATE WELL REPORT

Part 2

Pump Installer's Completion Report
Mississippi Department of Environmental Quality
Office of Land and Water Resources
P.O. Box 10631
Jackson, MS 39289-0631
(601)961-5210
(601)354-6938 (fax)

County: Sunflower
 Permit #: _____
 Driller: Irrigation Equipment
 Date completed: 8-7-07

For Office Use Only:

Aquifer: _____
 Well #: D-118
 Elevation: _____

This report should be prepared by the pump installer in detail and filed with the Department within 30 days of the installation of pump.


Well Owner Information	Well Location
Owner Name: <u>Robert Ed Connell</u>	Latitude: _____ Longitude: _____
Mailing Address: <u>1007 Farmers St.</u>	Method of Lat/Long (circle one): <input type="radio"/> Conventional Survey, <input type="radio"/> USGS quad, <input type="radio"/> Hand-held GPS, <input type="radio"/> Survey-grade GPS
<u>Cleveland Ms. 38732</u> City State Zip Code	<u>SE 1/4 NE 1/4 Sec 13 Twn 23N Rng 3W</u>
Telephone No. <u>(662) 515-4438</u>	Distance Direction Nearest Town <u>5 Miles NE of Drew</u>

Pump Type Circle one	Power Type Circle one
Air Lift <input type="checkbox"/> Jet <input type="checkbox"/> Submersible <input type="checkbox"/>	<input checked="" type="radio"/> Diesel Engine <input type="checkbox"/> Gasoline Engine <input type="checkbox"/> Natural Gas
Bucket <input type="checkbox"/> Piston <input type="checkbox"/> <input checked="" type="radio"/> Turbine <input type="checkbox"/>	Electric Motor <input type="checkbox"/> Hand <input type="checkbox"/> Tractor PTO <input type="checkbox"/>
Centrifugal <input type="checkbox"/> Rotary <input type="checkbox"/> Flowing Well <input type="checkbox"/>	Windmill <input type="checkbox"/> Other (specify): _____
Other (specify): _____	Horse Power Rating of Motor: <u>60</u>
Date Pump Installed: <u>8-8-07</u>	Setting Depth: <u>70</u> feet
Rated Pump Capacity: <u>2300 ±</u> Gallons Per Minute	Number of Stages: <u>2</u>

Pump Test Data	Method of Measuring Water Level Circle one
Date Well Tested: _____	Air Line <input type="checkbox"/> Electric Measuring Line <input type="checkbox"/> Steel Tape <input type="checkbox"/>
Static Water Level (A): _____ Feet Below Land Surface	Other (specify): _____
Pumping Water Level (B): _____ Feet Below Land Surface	For flowing well, measured shut in head: _____ feet
Drawdown [(B)-(A)]: _____ Feet Below Land Surface	Well yielded _____ GPM with a drawdown of _____ feet after _____ hours of pumping
Test Pumping Rate: _____ Gallons Per Minute	
Duration of Pump Test (minimum 4 hours): _____ hours	

I HEREBY CERTIFY that the above statements are true to the best of my knowledge.

Patrick M. Chism 0695
 Print Name of Pump Installer and License No. (if applicable)

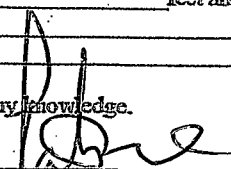
 Signature of Pump Installer

RECEIVED
 AUG 28 2007
 BY: OLWR

670 000 m 680 000 m 690 000 m

4 90° 35' 5 90° 30' 6 90° 25'

Robert Ed Connell Map

D-118

R 4 W

R 3 W

33° 55'

480 000 m

A

33° 50'

480 000 m

B


33° 45'

470 000 m

C

33° 40'

460 000 m

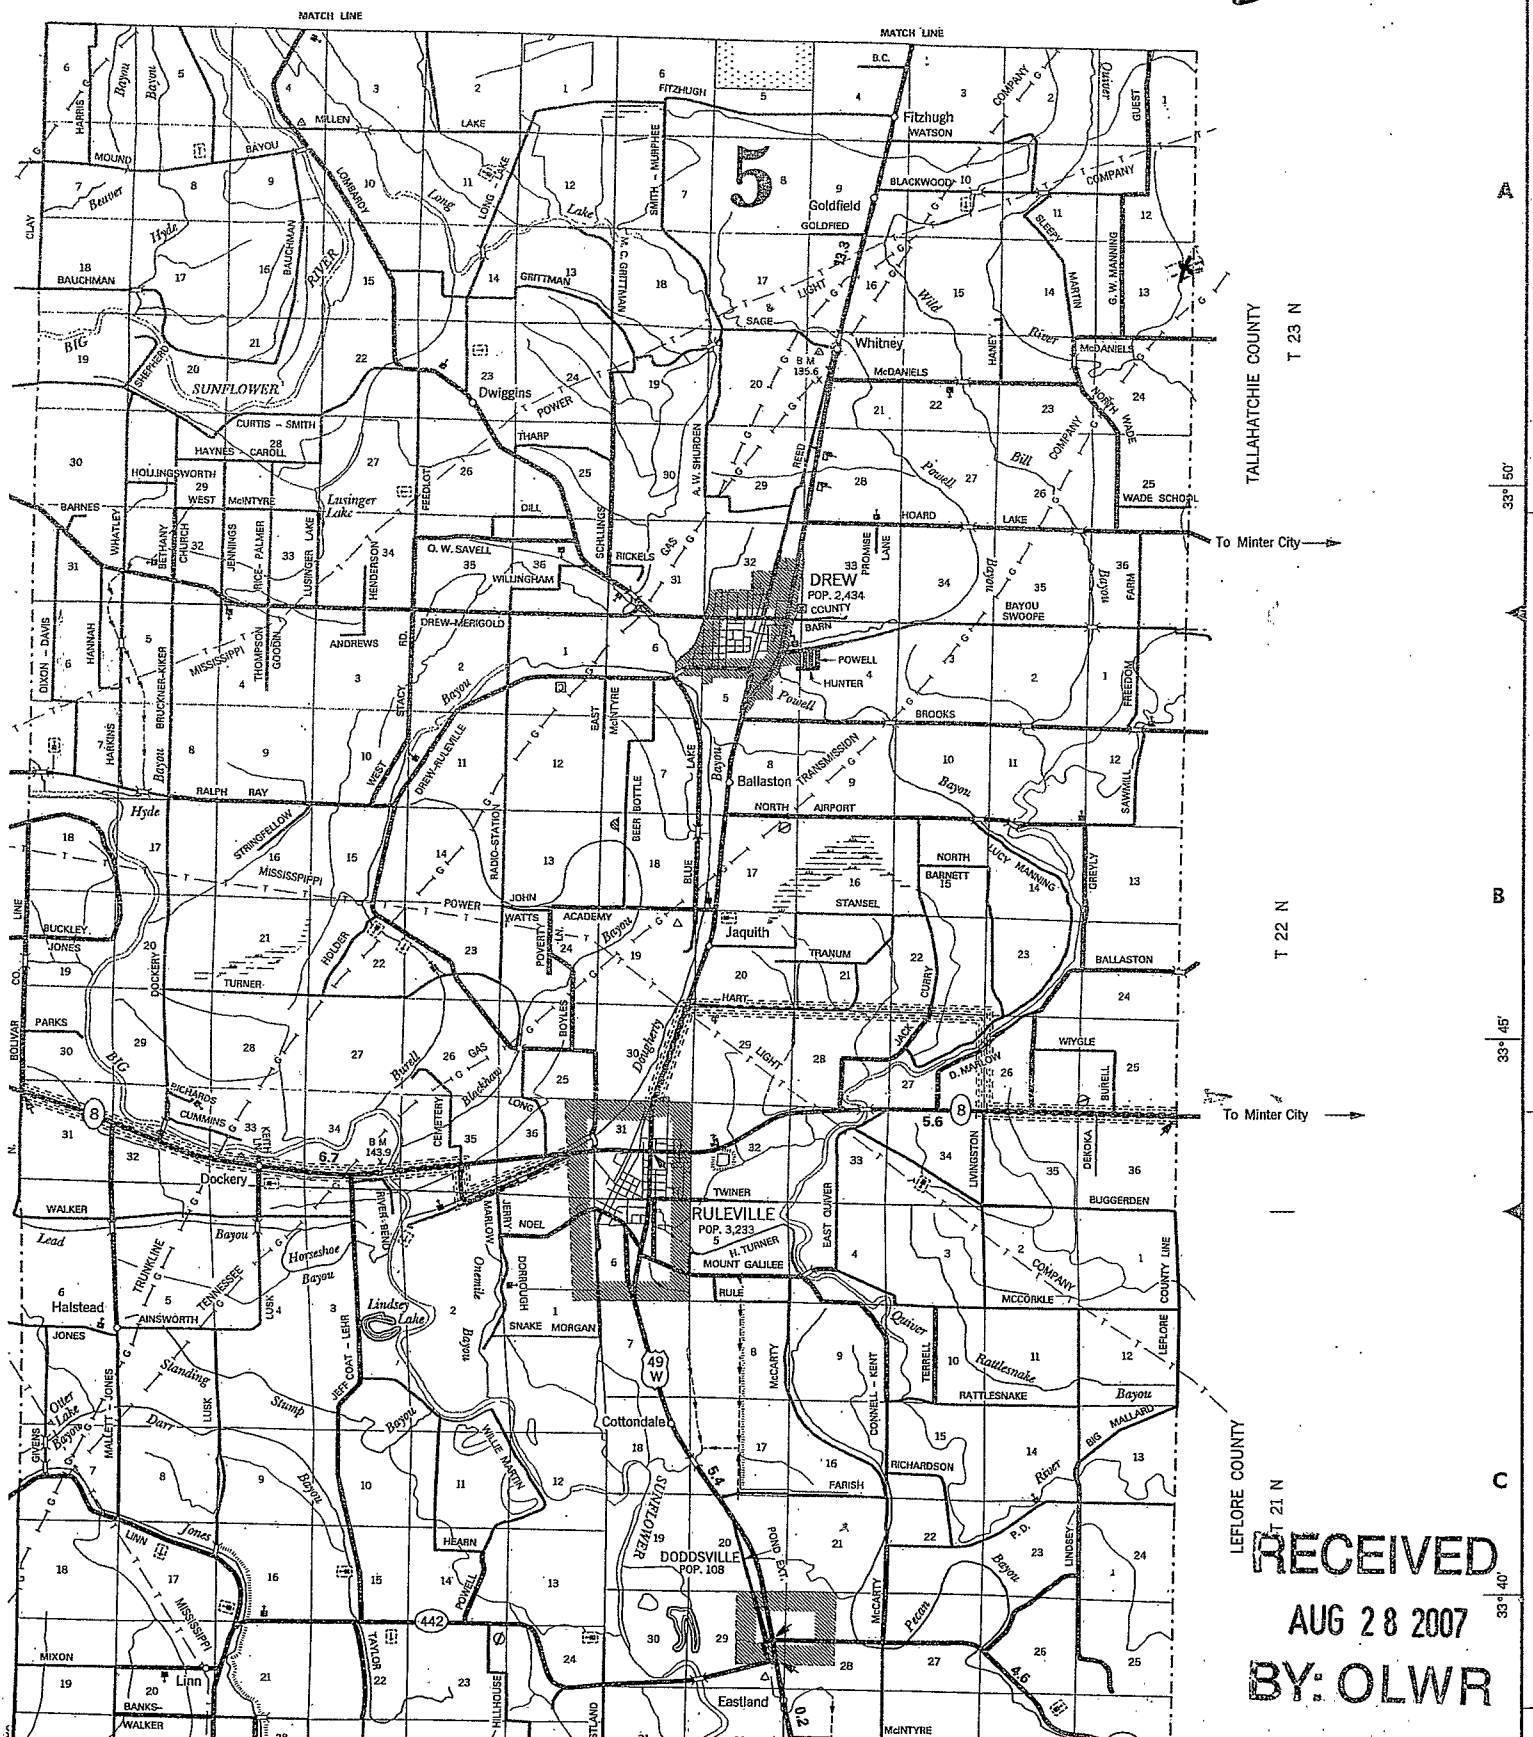

T 23 N

T 22 N

T 21 N

RECEIVED
 AUG 28 2007
 BY: OLWR