

Red Burns Promise Land

Red Hill  
Pivot

Platation 16"

# STATE WELL REPORT

County: Sunflower  
 Permit #: GW-49542 ✓  
 Driller: J. Newome 0-773  
 Date drilling completed: 6/17/16

**Part 1**  
**Driller's Log**  
 Mississippi Department of Environmental Quality  
 Office of Land and Water Resources  
 P.O. Box 2309  
 Jackson, MS 39225-2309  
 (601)961-5210  
 (601)360-0535 (fax)

**For Office Use Only:**  
 Well #: D151  
 Aquifer: \_\_\_\_\_  
 E-Log #: \_\_\_\_\_

State Law requires that this report be prepared by the license holder responsible for the work and filed with the Department at the above address within 30 days of completion of drilling of the well or borehole.

Well Owner Information (Landowner if borehole is not for a water well)	Well or Borehole Location
Owner Name: <u>Hampton Lake Farms</u>	Latitude: <u>33 49 08</u> Longitude: <u>90 30 29</u>
Mailing Address: <u>P.O. Box 60</u>	Method of Lat/Long (check one): Conventional Survey _____
<u>Glendora</u> <u>MS</u> <u>38928</u>	USGS quad _____ Hand-held GPS <input checked="" type="checkbox"/> Survey-grade GPS _____
City State Zip Code	<u>SW</u> <u>SE</u> <u>NE</u> <u>SW</u> 1/4 <u>NE</u> 1/4, Sec. <u>33</u> T <u>23</u> N R <u>03</u> W
Telephone No. ( ) _____	<u>1.2</u> Miles <u>NE</u> of <u>Prew</u>
	(Distance) (Direction) (Nearest Town)

**Well / Borehole Data**

Date drilling started: 6/17 Date drilling completed: 6/17 Hole depth: 120 Hole diameter: 24

Location of the source of any surface water used for drilling: Ditch

Method of dosing and volume of Chlorine used in drilling and development: \_\_\_\_\_

Logs run (circle all applicable): No log run Electric Gamma Ray Density Sonic Neutron Other: \_\_\_\_\_

Name of organization running log(s): \_\_\_\_\_

Purpose of borehole (circle one): Water Well Geotechnical/Geological Investigation Ground Source Heat Pump  
 Seismic Survey Other (describe) \_\_\_\_\_

*If drilling is not related to water well construction, skip the remainder of this block*

Purpose of Well (circle all applicable): Home Industrial Public Supply Irrigation Fish Culture

Other (describe): \_\_\_\_\_

If a flowing well, method of flow regulation: Valve \_\_\_\_\_ Other (describe) \_\_\_\_\_

Static Water Level: \_\_\_\_\_ feet [above or below] land surface Date measured: MAR 16 2017  
 (circle one)

Method of measurement (circle one): Steel tape Electric tape Air line Other (describe): \_\_\_\_\_

Well depth: 10 Well grouted to a depth of: 123 feet Type of grout (circle one): Neat Cement Bentonite Mix

Casing length: 80 feet Casing diameter: 16" inches Type of casing: PVC

Screen length: 40 feet Screen diameter: 16" inches Type of screen: PVC

Screen slot size: 0.50 inches Setting depth: From 80 feet to 120 feet

Type of completion (circle all applicable): Gravel packed Underreamed Open hole Natural Development

Other (describe): \_\_\_\_\_

Top of lap pipe or reduction in casing: \_\_\_\_\_ feet

*If telescoped or more than one screen, describe on next page*

RECEIVED

MAR 16 2017

BY OLSR



RECEIVED

MAR 16 2017

OLWR

STATE WELL REPORT

Part 2

Pump Installer's Completion Report
Mississippi Department of Environmental Quality
Office of Land and Water Resources
P.O. Box 2309
Jackson, MS 39225
(601)961-5210
(601)961-5228 (fax)

For Office Use Only:

Aquifer:
Well #: DIS1
Elevation:

County: Sanflower
Permit #: GW-49542
Driller: J. Newcome O-773
Date completed: 6/17/16
Copy information from block on Part 1

This part of the report must be completed by a licensed water well contractor or a licensed pump installer. A copy of Part 1 of the report must be attached and both parts filed with the Department at the above address within 30 days of well completion.


Well Owner Information: Hampton Lake Farms, P.O. Box 60, Glendora MS 38928
Well Location: Latitude: 33 49 08 Longitude: 90 30 29
Method of Lat/Long: Conventional Survey
USGS quad: SW 1/4 NE 1/4 Sec 33 T 23N R 03W
Distance: 1.2 Miles NE of Drew

Pump Type: Turbine
Power Type: Diesel Engine
Horse Power Rating of Motor: 60
Setting Depth: 20 feet
Number of Stages: 3

Pump Test Data: Not tested
Method of Measuring Water Level: Not Tested

This is for (circle one): New Well Replacement of Existing Pump Repair of Existing Pump

I HEREBY CERTIFY that the above statements are true to the best of my knowledge.
Hubbard Stephens 741-P
Signature of Pump Installer

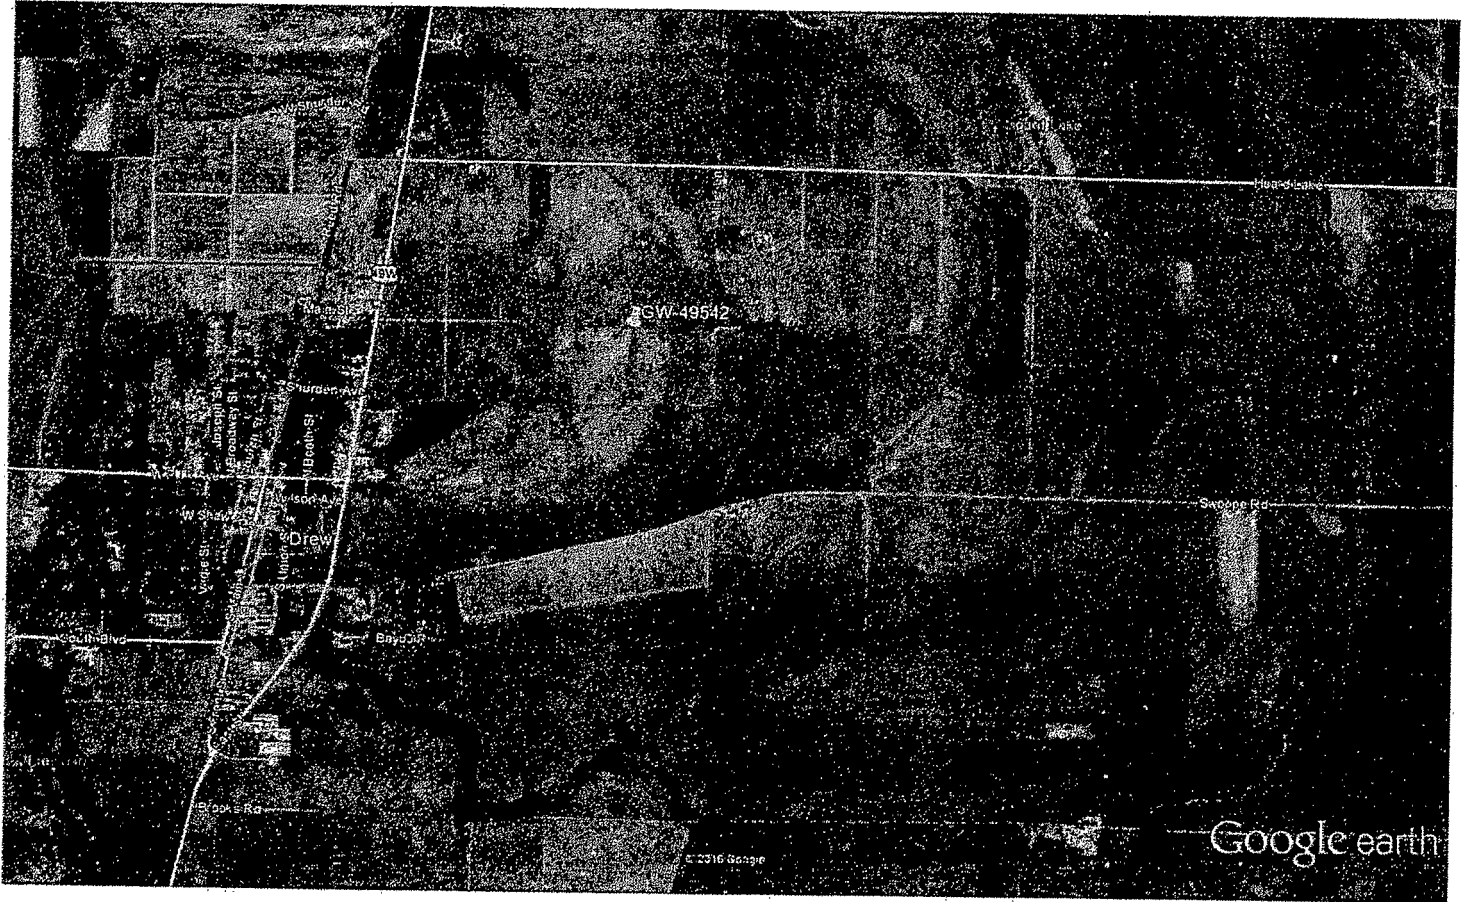

Google earth



RECEIVED

MAR 16 2017

BY OLWR



Dean A. Pennington, PhD  
Executive Director

P. O. Box 129  
Stoneville, MS 38776

Tel.: (662) 686-7712

Fax: (662) 686-9078

www.ymd.org

## Yazoo Mississippi Delta Joint Water Management District

June 14, 2016

Hampton Lake Farms  
PO Box 60  
Glendora, MS 38928

RE: Receipt for Notification of Construction of Replacement Well MS-GW-49542  
which will be replacing MS-GW-05385 located at  
Location: SW ¼ of the NE ¼ Section 33 Township 23N Range 03W County Sunflower  
Latitude: 334910 Longitude: 903027

Dear Hampton Lake Farms,

This letter acknowledges your notification to the state that you intend to replace a previously permitted well in the Mississippi River Valley Alluvial Aquifer and that this replacement construction will meet the requirements for a groundwater replacement well specified in 11 Miss. Admin. Code Part 7, Chapter 1, Rule 1.4.F.1 (see attached/back of page). Construction may begin immediately on your replacement well.

Remember that you are still required to submit a permit application (enclosed) for the replacement well within 5 days of construction beginning. You are also required to properly decommission (plug and abandon) the replaced well within 180 days of the replacement well's construction.

A copy of this letter, or a water use permit for the replacement well, must be attached to the State Well Report submitted by your driller to MDEQ and they must also submit a copy to YMD, as specified in the Water Well Contractor regulations found in 11 Miss. Admin. Code Part 7, Chapter 2, Rule 2.9.

If you have any questions, please call YMD at 662-686-7712.

Sincerely,

*Dillard Melton Jr.*

Dillard Melton Jr.  
Permitting Director

DIS1

