

MISSISSIPPI DEPARTMENT OF NATURAL RESOURCES

Bureau of Land and Water Resources

Southport Mall

P.O. Box 10631

Jackson, Mississippi 39209

WATER WELL DRILLERS LOG

4-25

1990

5 County

F.E. Mitchell

Sunflower

date well completed

firm name

county well located

LANDOWNER: F.E. Mitchell

PO Box 117

Rome Ms 38768
(mailing address)

WELL LOCATION:

sec 23 T 23 N R 3 E
S W
5 miles ^{Northwest} of ^{Drew}
(distance) (direction) (nearest town)

WELL PURPOSE:

(home, irrigation, municipal, industrial)

WELL COMPLETION DATA:


- (1) diameter (inches) 16
- (2) total depth (feet) 97
- (3) static water level (feet) 25 ^{below} _{above} top of ground.
- (4) casing steel (material), 57 (depth)
If telescope see back.
(size)
- (5) screen 40 (length), 57 (depth, to top)
16 (size), steel (material)
- (6) pump _____ (HP) _____ (yield gpm)
(type power)
- (7) electric log _____ (yes or no)
(organization running log)
- (8) how well bottom plugged steel plate

description of formations encountered

from

to

Topsoil	0	3
Clay	3	40
Coke Sand	40	55
pea gravel	55	60
Rock	60	97

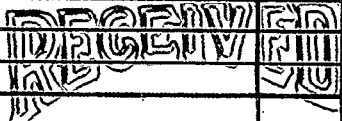


MAY 26 1992

Dept. of Environmental Quality
BUREAU OF LAND & WATER RESOURCES

DRILLERS REMARKS:

If well telescopes please sketch and show depths.

GROUND LEVEL

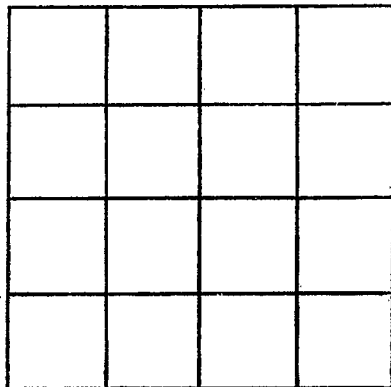

SECTION _____

Please indicate well location X.

ADDITIONAL INFORMATION

If more than one screen, show locations of each on sketch.