

**MISSISSIPPI DEPARTMENT OF NATURAL RESOURCES**  
Bureau of Land and Water Resources

P.O. Box 10631  
Jackson, Mississippi 39209  
**WATER WELL DRILLERS LOG**

108C  
COUNTY WELL LOCATED  
*Sunflower*

WELL NUMBER *D* CODED

DATE WELL COMPLETED  
*2004*  
*5-7-91*

PERMIT NUMBER

NAME OF DRILLING FIRM  
*Dyn Well*

NAME & MAILING ADDRESS OF LANDOWNER  
*J.C. Haney*

*221 Green Ave*

*Drew Ms. 38737*

WELL LOCATION: SEC TOWNSHIP RANGE  
*23 23 N 3 E*

DISTANCE DIRECTION NEAREST TOWN  
\_\_\_\_\_ Miles \_\_\_\_\_ of \_\_\_\_\_

OTHER LANDMARK

WELL PURPOSE: Home Irrigation, Municipal, Industrial, Fish Pond, etc.

**PUMP DATA**

PUMP TYPE (Circle One):  
Submersible, Turbine, Jet Flowing Well,  
Other (Describe) \_\_\_\_\_

POWER TYPE (Circle One):  
Electric, Tractor, Diesel, Gasoline, Butane,  
Other (Describe) \_\_\_\_\_ H/P \_\_\_\_\_

Pump Capacity (GPM) No. of Stages Setting Depth  
*2000 2 60* FT.

PUMP TEST  
Well yielded \_\_\_\_\_ GPM with  
a drawdown of \_\_\_\_\_ ft.  
after \_\_\_\_\_ hours of pumping

**WELL DATA**

Well Depth <i>116'</i>	Casing Diameter (In.) <i>16"</i>	Casing Length (Ft.) <i>76'</i>
Type of Casing <i>steel</i>	Hole Depth	Depth to Static Water Level

TYPE OF COMPLETION: (Circle One or More):  
Gravel Packed, Underreamed, Telescoped,  
Natural Development, Open Hole, Other  
(Describe) \_\_\_\_\_

Top of Lap Pipe or Reduction in Casing  
FEET IF TELESCOPED OR MORE THAN ONE SCREEN: USE BACK PAGE

**LOG DATA**

TYPE OF LOG RUN (Circle One):  
Electric, Gamma Ray, Density, Sonic, Neutron,  
Other (Describe) \_\_\_\_\_

Name of Organization Running Log  
*None*

**SCREEN DATA**

Diameter - Inches <i>16"</i>	Length - Feet <i>40'</i>	Slot Size - Inches <i>.030</i>
Screen Type <i>Wire Wrap</i>	Depth to Bottom - Feet	

**GEOLOGIC DATA (Office Use Only)**

Surface Elev.	Geologic Unit	Unit Thickness	Depth to Top
Subs. SWL	Date	Analysis	Aquifer Test

Driller's Remarks

DESCRIPTION OF FORMATIONS ENCOUNTERED	FROM	TO	FORMATIONS (Continued)	
			FROM	TO
<i>Clay</i>	<i>0</i>	<i>33</i>	<b>RECEIVED</b>  <i>JUL 23 1991</i>	
<i>Fine Sand</i>	<i>33</i>	<i>46</i>		
<i>Fine Sand + Gravel</i>	<i>46</i>	<i>70</i>		
<i>M Sand + Gravel</i>	<i>70</i>	<i>116</i>		

Dept. of Environmental Quality  
Bureau of Land & Water Resources


IF MORE SPACE IS NEEDED, USE BACK

If well telescopes please  
sketch and show depths.

---

GROUND LEVEL

---

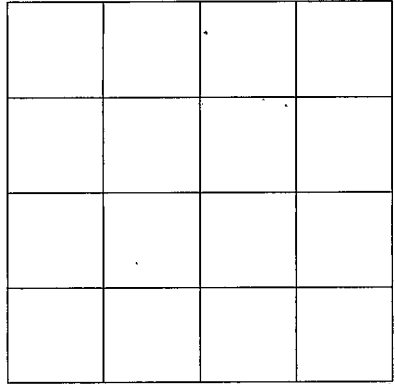

SECTION \_\_\_\_\_

Please indicate well location X.

---

ADDITIONAL INFORMATION

---

If more than one screen,  
show location of each on sketch.

---