

E 13
12-23-64

WATER WELL DRILLERS LOG

CODED

Date: 12/23, 1964, Driller: Dutton Well Supply County: Jefferson
(Name)

| | Description & Color of Materials Sand, Clay, Red Clay, Shell, etc. | Thick- ness Feet | Depth Feet |
|--|---|------------------------|--------------------------|
| (1) Owner of Land: <u>W. F. Moses &</u> (Name) <u>J. J. Caf. Buckville, Miss.</u> (Address) | <u>Last Log Brook</u> | | |
| (2) Location: <u>1/4</u> , <u>1/4</u> , Sec. <u>13</u> <u>22</u> , <u>4</u> <u>2</u> miles <u>Na. West</u> of <u>Buckville</u> (distance) (direction) (Nearest Town) | | | |
| (3) Topography: <input checked="" type="checkbox"/> (Hilly) <input type="checkbox"/> (Flat) <input type="checkbox"/> (Level) | | | |
| (4) Purpose of Well: <u>domestic</u> (Domestic Irrigation Municipal, Industrial, Other) | <u>Sand med</u> | <u>32</u> | <u>630</u> <u>662</u> |

Information upon completion of well:


- (1) Diameter 4 1/2 inches.
- (2) Total Depth 662 feet.
- (3) Water Level 24 feet below top of ground.
- (4) Cased to _____, Size _____
- (5) Screen: Size 2, Length 20
- (6) Were any formations sealed against pollution?
_____ yes, _____ no.

If YES depth of formation _____

Why _____

Drillers Remarks: _____

CODED

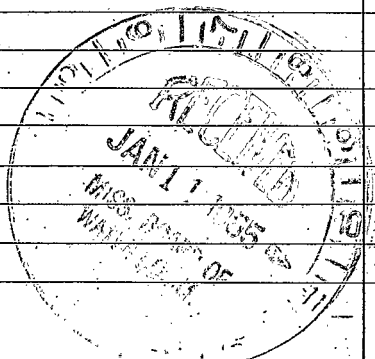

(Use Back Side)

Well No.

