

SUNFLOWER

~~ROLLTOP~~
E14
6-14-71

MISSISSIPPI
BOARD OF WATER COMMISSIONERS
416 North State Street
Jackson, Mississippi 39201

CODED

WATER WELL DRILLERS LOG

6/14 1971 Delta Well & Supply Co. ~~Rolltop~~
date well completed firm name county well located

LANDOWNER:
Imogene Pruden
P.O. 2 - Cleveland Miss.
(mailing address)

WELL LOCATION:
sec. 18 T 22 N R 4 E
4 1/2 miles N 10 East of Cleveland
(distance) (direction) (nearest town)

WELL PURPOSE: Home
(home, irrigation, municipal, industrial)

- WELL COMPLETION DATA:
- (1) diameter (inches) 4 1/2
 - (2) total depth (feet) 693
 - (3) static water level (feet) 29 below top of ground.
 - (4) casing gal steel (material) (depth) (size) if telescope see back.
 - (5) screen 20 (length) (depth to top) (size) Standard steel (material)
 - (6) pump 1/2 (HP) 19 (yield gpm) elec (type power)
 - (7) electric log No (yes or no) (organization running log)
 - (8) how well bottom plugged R.P. Pruden

description of formations encountered	from	to
top soil	0	23
Fine sand	23	83
Coarse sand & gravel	83	140
Fine sand	140	203
Clay	203	243
Sand	243	283
Sand & shale	283	323
Sand fine	323	363
Clay	363	403
Shale	403	503
Sand fine	503	583
Sand Med.	583	693
Clay		

CODED


JUN 14 1971

MISS. BD. OF
WATER COMM.

DRILLERS REMARKS:
Luther R. Ruffin

If well telescopes please sketch and show depths.

GROUND LEVEL

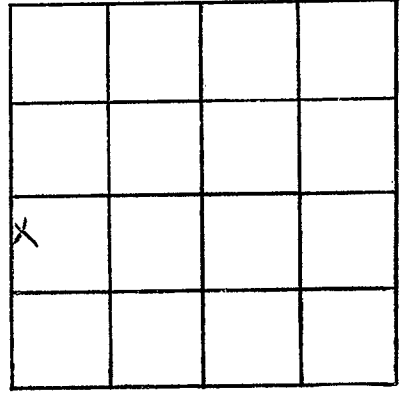

SECTION 18

Please indicate well location X.

ADDITIONAL INFORMATION

A series of horizontal lines for writing additional information.

If more than one screen, show locations of each on sketch.