

SUNFLOWER

~~33~~ E 16

7-20-73

MISSISSIPPI  
BOARD OF WATER COMMISSIONERS  
416 North State Street  
Jackson, Mississippi 39201

**CODED**

WATER WELL DRILLERS LOG

7/20

/date well completed

19 95 Delta Mechanical Co Sunflower

firm name

county well located

LANDOWNER: W.M. Jackson

Riverside Farm  
Chickland, Miss.  
(mailing address)

description of formations encountered

from

to

Safe soil

0

30

Fine sand clay

30

70

Sand & gravel

70

150

Blue clay & sand

150

360

shales mud st.

360

592

sand

592

651

sand

592

651

WELL LOCATION:

sec. 18 T. 22 N. R. 4 E

3 1/2 miles W of Chickland  
(distance) (direction) (nearest town)

WELL PURPOSE:

(home, irrigation, municipal, industrial)

WELL COMPLETION DATA:

- (1) diameter (inches) 4x2
- (2) total depth (feet) 651
- (3) static water level (feet) 26 below above top of ground.
- (4) casing 4x2 steel  
(material) (depth)

(size) if telescope see back.

- (5) screen 20 ft  
(length) (depth to top)  
2" standard steel  
(size) (material)
- (6) pump 1 1/2 28  
(HP) (yield gpm)  
elec  
(type power)

- (7) electric log no  
(yes or no)

(organization running log)


- (8) how well bottom plugged 3 7/8 in. hole

DRILLERS REMARKS:

7/20/73

If well telescopes please sketch and show depths.

GROUND LEVEL

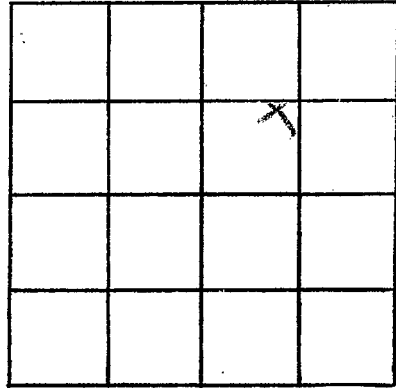

SECTION 16

Please indicate well location X.

ADDITIONAL INFORMATION

A series of horizontal lines for additional information.

If more than one screen, show locations of each on sketch.