


SUNFLOWER
E 17
1-26-74

MISSISSIPPI
 BOARD OF WATER COMMISSIONERS **CODED**
 416 North State Street
 Jackson, Mississippi 39201
WATER WELL DRILLERS LOG

January 26, 1974 Singer-Layne Central Div. Sunflower
 date well completed firm name county well located


LANDOWNER:	description of formations encountered	from	to
Sterling Dugger	Clay	0	18
Ruleville, Mississippi	Coarse Sand	18	30
(mailing address)	Coarse Sand & Pea Gravel	30	75
WELL LOCATION:	Big Gravel	75	111
sec. 8 T. 22 N. R. 4 E. W.	Cemented Rock	111	112
8 miles East of Cleveland			
(distance) (direction) (nearest town)			
WELL PURPOSE: Irrigation			
(home, irrigation, municipal, industrial)			
WELL COMPLETION DATA:			
(1) diameter (inches) 16"			
(2) total depth (feet) 112'			
(3) static water level (feet) 20 below top of ground.			
(4) casing Steel 52' (material) (depth)			
16" (size) if telescope see back.			
(5) screen 60' 112' (length) (depth to top)			
16" Steel (size) (material)			
(6) pump 50 2400 (HP) (yield gpm)			
Electric (type power)			
(7) electric log No (yes or no)			
(organization running log)			
(8) how well bottom plugged Plate			
DRILLERS REMARKS:			

CODED

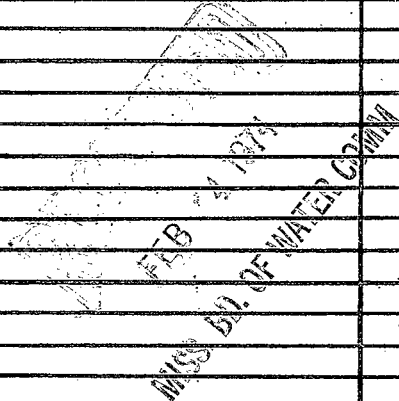

If well telescopes please sketch and show depths.

GROUND LEVEL

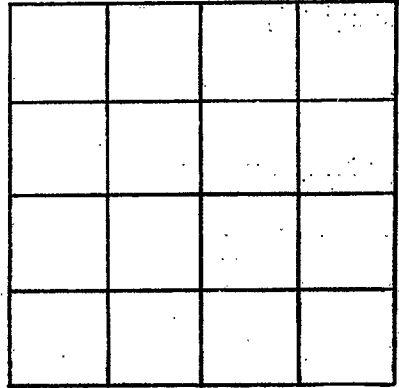

SECTION _____

Please indicate well location X.

ADDITIONAL INFORMATION

If more than one screen,
show locations of each on sketch.