

C17179

Well #2

CODED

SEP 12 1973

SUNFLOWER
E 18
8-13-73



MISSISSIPPI
BOARD OF WATER COMMISSIONERS
416 North State Street
Jackson, Mississippi 39201

MISS. BD. OF
WATER COMMISSIONERS

WATER WELL DRILLERS LOG
SINGER LAYNE


August 13, 1973 Sunflower County Sanitation Sunflower
date well completed firm name Land Fill county well located

LANDOWNER:	description of formations encountered	from	to
Sunflower County Sanitation			
Land Fill	Clay	0	30
Indianola, Mississippi	Coarse Sand	30	45
(mailing address)	Coarse Sand & Gravel	45	100
WELL LOCATION: sec. 16 T. 24 N. R. 4 W Indianola (distance) (direction) (nearest town)			
WELL PURPOSE: Industrial (home, irrigation, municipal, industrial)			
WELL COMPLETION DATA:			
(1) diameter (inches) 4"			
(2) total depth (feet) 100'			
(3) static water level (feet) 18' below top of ground.			
(4) casing Steel 60' (material) (depth)			
4" (size) if telescope see back.			
(5) screen 40' 100' (length) (depth to top)			
4" Steel (size) (material)			
(6) pump 5 45 (HP) (yield gpm)			
electric (type power)			
(7) electric log No (yes or no)			
(organization running log)			
(8) how well bottom plugged Plate			
DRILLERS REMARKS:			

CODED

If well telescopes please sketch, and show depths.

GROUND LEVEL

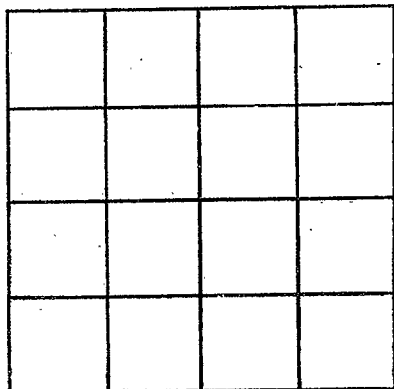

SECTION _____

Please indicate well location X.

ADDITIONAL INFORMATION

If more than one screen,
show locations of each on sketch.