

SUNFLOWER
E 19
10/20/74

MISSISSIPPI
BOARD OF WATER COMMISSIONERS CODED
416 North State Street
Jackson, Mississippi 39201

WATER WELL DRILLERS LOG

10/26/74 19 date well completed
Ottawa Well & Supply Co. firm name
Sunflower county well located


LANDOWNER:
Dobson Baptist Church
Pt. Cleveland Miss.
(mailing address)

description of formations encountered	from	to
top clay	0	16
loam	16	112
yellow sand	112	125
clay	125	250
sand	250	330
clay	330	545
sand & shale	545	560
sand	560	610
clay	610	725
sand	725	788
clay	788	788

WELL LOCATION:
sec 32 T 22 N R 4 E
4 miles East of Sunflower
(distance) (direction) (nearest town)

WELL PURPOSE: domestic
(home, irrigation, municipal, industrial)

- WELL COMPLETION DATA:
- (1) diameter (inches) 4 X 2
 - (2) total depth (feet) 714
 - (3) static water level (feet) 28 below top of ground.
 - (4) casing owl steel (material) (depth)
 - (size) If telescope see back.
 - (5) screen 20 (length) (depth to top)
2 (size) (material) Standard Steel
 - (6) pump 1/2 (HP) 12 (yield gpm)
elec (type power)
 - (7) electric log NO (yes or no)
 - (organization running log)
 - (8) how well bottom plugged B. P. ...

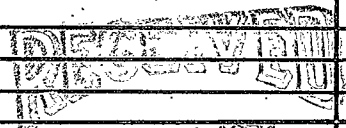


NOV - 4 1974

DRILLERS REMARKS:

If well telescopes please sketch and show depths.

GROUND LEVEL

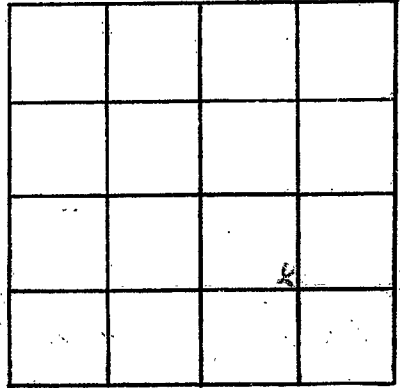

SECTION 22

Please indicate well location X.

ADDITIONAL INFORMATION

Lined area for additional information.

If more than one screen, show locations of each on sketch.