

Sunflower
E 20
7-68

MISSISSIPPI
BOARD OF WATER COMMISSIONERS
416 North State Street
Jackson, Mississippi 39201

00000

WATER WELL DRILLERS LOG

7/23 1968 Delta Well & Supply Sunflower
date well completed firm name county well located

LANDOWNER:
Dell Love
R. F. D. Merriold
(mailing address)

description of formations encountered	from	to
Top Clay	0	22
Sand	22	26
Sand & shells	26	25
Sand & gravel	25	120

WELL LOCATION:
sec. 5 T 22 N R 4 X
5 miles West of Drew
(distance) (direction) (nearest town)

WELL PURPOSE: Irrigation
(home, irrigation, municipal, industrial)


- WELL COMPLETION DATA:
- (1) diameter (inches) 10
 - (2) total depth (feet) 120
 - (3) static water level (feet) 24 below top of ground.
 - (4) casing steel (material), (depth)
 - (size) if telescope see back.
 - (5) screen 24 (length), (depth) to top
10" (size), steel (material)
 - (6) pump 900 (HP), (yield gpm)
Granton (type power)
 - (7) electric log (yes or no)
(organization running log)
 - (8) how well bottom plugged Concrete

JUL 26 1968
MISS. BOARD OF
WATER COMMISSIONERS

DRILLERS REMARKS:

If well telescopes please sketch and show depths.

GROUND LEVEL

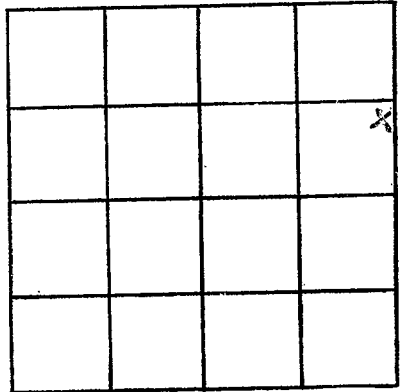

SECTION 6

Please indicate well location X.

ADDITIONAL INFORMATION

If more than one screen, show locations of each on sketch.