

Sunflower
E 21
8-68


MISSISSIPPI
 BOARD OF WATER COMMISSIONERS
 416 North State Street
 Jackson, Mississippi 39201

8/8/68
 JW
 C2717

WATER WELL DRILLERS LOG

August 1, 1968 Layne-Central Company Sunflower
 date well completed firm name county well located


LANDOWNER: Sterling Dugger	description of formations encountered	from	to
	Clay	0	17
	Fine sand	17	45
Ruleville, Mississippi	Coarse sand	45	75
(mailing address)	Coarse sand, big boulders	75	107
WELL LOCATION: <u>lots 1 & 2</u>			
sec. <u>17</u> T. <u>22N</u> R. <u>4E</u>			
<u>8</u> miles <u>NE</u> of <u>Cleveland</u>			
(distance) (direction) (nearest town)			
WELL PURPOSE: <u>irrigation</u>			
(home, irrigation, municipal, industrial)			
WELL COMPLETION DATA:			
(1) diameter (inches) <u>18</u>			
(2) total depth (feet) <u>107</u>			
(3) static water level (feet) <u>17' 2"</u> xxxx above top of ground.			
(4) casing <u>steel</u> , <u>67'</u> , (material) (depth), <u>18"</u> xxxxxxxx (size) if telescope see back.			
(5) screen <u>40'</u> , <u>107'</u> (length) (depth to top) <u>18"</u> , <u>slotted pipe</u> (size) (material)			
(6) pump <u>50</u> <u>2000</u> (HP) (yield gpm) <u>engine</u> (type power)			
(7) electric log <u>no</u> (yes or no) <u></u> (organization running log)			
(8) how well bottom plugged <u>plate</u>			

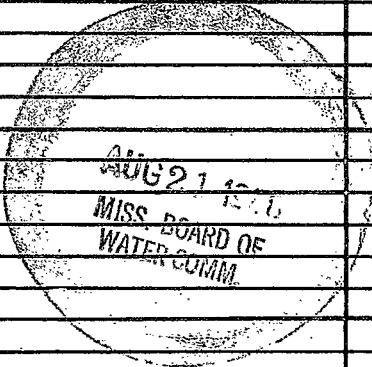

DRILLERS REMARKS:

If well telescopes please
sketch and show depths.

GROUND LEVEL

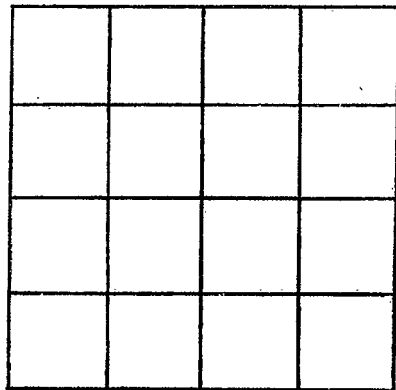

SECTION _____

Please indicate well location X.

ADDITIONAL INFORMATION

If more than one screen,
show locations of each on sketch.