

E 22
10-66

WATER WELL DRILLERS LOG

Date: 10/10, 1966, Driller: Delta Well Supply Co County Sunflower
(Name)

(1) Owner of Land: Will Kearock
(Name)
R. F. D. Cleveland
(Address)

(2) Location: SW 1/4, NW 1/4, Sec. 32 T22R4Y
3 miles East of Cleveland
(distance) (direction) (Nearest Town)

(3) Topography: (Hilly) (Flat) (Level)

(4) Purpose of Well: Domestic
(Domestic Irrigation, Municipal, Industrial, Other)

Description & Color of Materials Sand, Clay, Red Clay, Shell, etc.	Thick- ness Feet	Depth Feet
<u>Top soil</u>	<u>25</u>	<u>25</u>
<u>Fine sand</u>	<u>35</u>	<u>60</u>
<u>Sand & gravel</u>	<u>15</u>	<u>125</u>
<u>Clay</u>	<u>5</u>	<u>130</u>
<u>Rock</u>	<u>2</u>	<u>132</u>
<u>Clay</u>	<u>20</u>	<u>162</u>
<u>Frisk sand</u>	<u>23</u>	<u>185</u>
<u>Clay</u>	<u>10</u>	<u>195</u>
<u>Sand med</u>	<u>125</u>	<u>320</u>
<u>hard clay & shale</u>	<u>365</u>	<u>685</u>
<u>Sand med</u>	<u>40</u>	<u>725</u>
<u>Clay</u>	<u>?</u>	<u>?</u>

Information upon completion of well:

(1) Diameter 4 X 2 inches.

(2) Total Depth 723 feet.

(3) Water Level 23 feet below top of ground.

(4) Cased to _____, Size _____


(5) Screen: Size 2, Length 20 ft.

(6) Were any formations sealed against pollution?
_____ yes, no.

123 ft 4" gal pipe
2" gal pipe
20 ft 1/2" S. screen

If YES depth of formation _____
Why _____

Drillers Remarks: _____

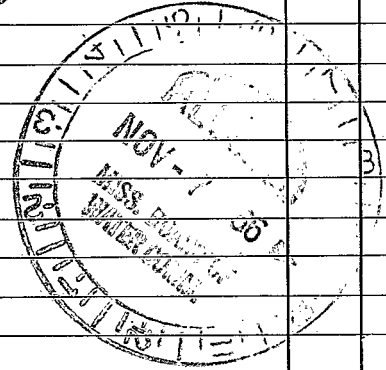

(Use Back Side)

Well No.

