

Sunflower
E 23
5-67

MISSISSIPPI
BOARD OF WATER COMMISSIONERS
416 North State Street
Jackson, Mississippi 39201

WATER WELL DRILLERS LOG

May 10 1967 date well completed BUTANE GAS OF GREENWOOD firm name Sunflower county well located

LANDOWNER:

EARL C. WILLIAMS

description of formations encountered

from

to

RT 1 Memphis, Miss (mailing address)

TOP SOIL	0	15
RED SAND & CLAY	15	60
COARSE SAND & FINE GRAVEL	60	90

WELL LOCATION:


sec. 3 T. 22 N R. 4 E
S W
5 miles W of DREW
(distance) (direction) (nearest town)

WELL PURPOSE: IRRIGATION
(home, irrigation, municipal, industrial)

WELL COMPLETION DATA:


- (1) diameter (inches) 10"
- (2) total depth (feet) 90'
- (3) static water level (feet) 2' below above top of ground.
- (4) casing STEEL, 70',
(material) (depth)
10" if telescope see back.
(size)
- (5) screen 20', 70'
(length) (depth to top)
10", STEEL
(size) (material)
- (6) pump 10 600
(HP) (yield gpm)
TRACTOR
(type power)
- (7) electric log No
(yes or no)
(organization running log)
- (8) how well bottom plugged
STEEL PLATE

DRILLERS REMARKS:

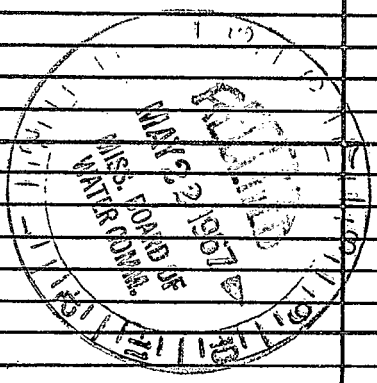

If well telescopes please sketch and show depths.

GROUND LEVEL

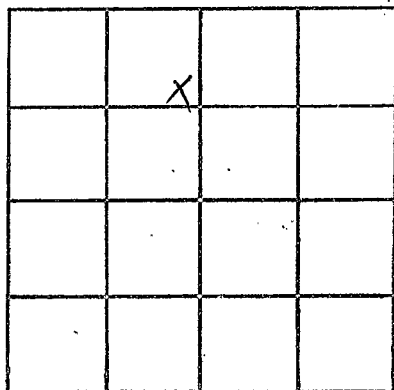

SECTION 3

Please indicate well location X.

ADDITIONAL INFORMATION

If more than one screen,
show locations of each on sketch.