

Sunflower
 E 25
 11-67
 11/4/67

MISSISSIPPI
 BOARD OF WATER COMMISSIONERS
 416 North State Street
 Jackson, Mississippi 39201

WATER WELL DRILLERS LOG

date well completed 19 *67* *Delta Well & Supply Co. Sunflower* firm name *Sunflower* county well located

LANDOWNER:
R.S. Bruckner
R.F.D. Mericidol
 (mailing address)

WELL LOCATION:
 sec *5* T *22* N R *4* E
5 1/2 miles *west* of *Drew*
 (distance) (direction) (nearest town)


WELL PURPOSE:
 (home, irrigation, municipal, industrial)

WELL COMPLETION DATA:

- (1) diameter (inches) *4 1/2*
- (2) total depth (feet) *1212*
- (3) static water level (feet) *12* below above
top of ground.
- (4) casing *galv. pipe* *1192*
(material) (depth)
(size) if telescope see back.
- (5) screen *20* *1192*
(length) (depth to top)
24 *Stainless Steel*
(size) (material)
- (6) pump *3/4* *20*
(HP) (yield gpm)
3/4
(type power)
- (7) electric log (yes or no)
(organization running log)
- (8) how well bottom plugged *BPV*

description of formations encountered	from	to
<i>Sand clay</i>	<i>0</i>	<i>20</i>
<i>Fine sand</i>	<i>20</i>	<i>15</i>
<i>Sand gravel</i>	<i>65</i>	<i>110</i>
<i>Clay</i>	<i>110</i>	<i>120</i>
<i>Sand</i>	<i>120</i>	<i>140</i>
<i>Shale</i>	<i>140</i>	<i>160</i>
<i>Sand</i>	<i>160</i>	<i>190</i>
<i>shale</i>	<i>190</i>	<i>210</i>
<i>sand</i>	<i>210</i>	<i>230</i>
<i>Clay & shale</i>	<i>230</i>	<i>295</i>
<i>Sand Fine</i>	<i>295</i>	<i>325</i>
<i>shale</i>	<i>325</i>	<i>365</i>
<i>sand Fine</i>	<i>365</i>	<i>400</i>
<i>shale & clay</i>	<i>400</i>	<i>620</i>
<i>Mud. sand. shale</i>	<i>620</i>	<i>650</i>
<i>shale</i>	<i>650</i>	<i>700</i>
<i>Sand Fine</i>	<i>700</i>	<i>715</i>
<i>shale</i>	<i>715</i>	<i>800</i>
<i>Fine sand gravel</i>	<i>800</i>	<i>810</i>
<i>shale sand</i>	<i>810</i>	<i>825</i>
<i>Medium sand Fine</i>	<i>825</i>	<i>885</i>
<i>clay & clay</i>	<i>885</i>	<i>905</i>
<i>sand with shell</i>	<i>905</i>	<i>930</i>
<i>medium sand with sand</i>	<i>930</i>	<i>1160</i>
<i>1 sand med.</i>	<i>1160</i>	<i>1215</i>
<i>clay</i>	<i>1215</i>	<i>?</i>

DRILLERS REMARKS:

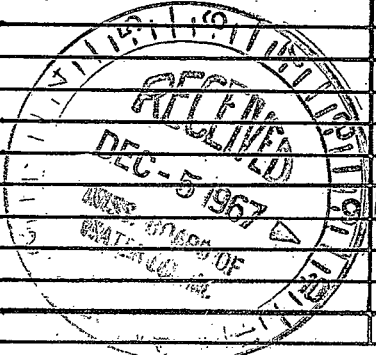

If well telescopes please sketch and show depths.

GROUND LEVEL



		X	

SECTION 5

Please indicate well location X.

ADDITIONAL INFORMATION

If more than one screen, show locations of each on sketch.