

**MISSISSIPPI  
BOARD OF WATER COMMISSIONERS**  
416 North State Street  
Jackson, Mississippi 39201

**WATER WELL DRILLERS LOG**

DEC 15 1967 Burns Gas of Greenwood Sunflower  
 date well completed firm name county well located


LANDOWNER:  
JOHN C. LUHA  
RT - Ruleville, Miss.  
(mailing address)

WELL LOCATION:  
sec. 34 T. 22 N. R. 4 W.  
2 miles W of Ruleville  
(distance) (direction) (nearest town)

WELL PURPOSE: Home  
(home, irrigation, municipal, industrial)

- WELL COMPLETION DATA:
- (1) diameter (inches) 4" x 2"
  - (2) total depth (feet) 671'
  - (3) static water level (feet) 28 below top of ground, 105' above
  - (4) casing 2" - 546' (material) (depth)  
4 1/2" (size) if telescope see back.
  - (5) screen 20 (length) 651' (depth to top)  
2" (size) STAINLESS STEEL (material)
  - (6) pump 1 (HP) 10 (yield gpm)  
ELECTRIC (type power)
  - (7) electric log No (yes or no)  
(organization running log)
  - (8) how well bottom plugged BACK PRESSURE VALVE

description of formations encountered	from	to
<u>HARD PACKED SAND</u>	<u>590</u>	<u>682</u>

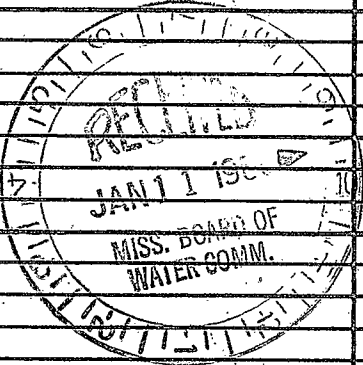

DRILLERS REMARKS:

