

Sunflower

~~0-7~~ E 27

5-7-70

5-7

MISSISSIPPI BOARD OF WATER COMMISSIONERS
416 North State Street
Jackson, Mississippi 39201

WATER WELL DRILLERS LOG

1970 Delta Well Supply Sunflower
date well completed firm name county well located

LANDOWNER:

Kelly

description of formations encountered

from

to

Rudolph Z. Kelly

RFD 2 Box 966 Cleveland
(mailing address)

Clay

0 22

Sand

22 136

Rock

136 137

fine sand

137 312

Shale Hard

312 326

Sand

326 345

Clay & Shale

345 498

Rock

498 500

Shale

500 550

Sand Shale

550 589

Hard Shale

589 596

WELL LOCATION:

sec. 19 T²⁴ N²² R. 7 E
6 miles N of Rulerilla
(distance) (direction) (nearest town)

WELL PURPOSE: home
(home, irrigation, municipal, industrial)

WELL COMPLETION DATA:

(1) diameter (inches) 4" x 2"

(2) total depth (feet) 713

(3) static water level (feet) 36 below top of ground.

(4) casing PVC (material) (depth)

(size) If telescope see back.

(5) screen 20 (length) (depth to top)

2" Stainless Steel (size) (material)

(6) pump 1 (HP) 30 (yield gpm)

Ele (type power)

(7) electric log no (yes or no)

(organization running log)

(8) how well bottom plugged

Shale

596 720

Shale

720 732

Sand

732 740

Shale

740 812



MAY 20 1970

MISS. BD. OF WATER COMMISSIONERS

DRILLERS REMARKS: Kelly

If well telescopes please sketch and show depths.

GROUND LEVEL

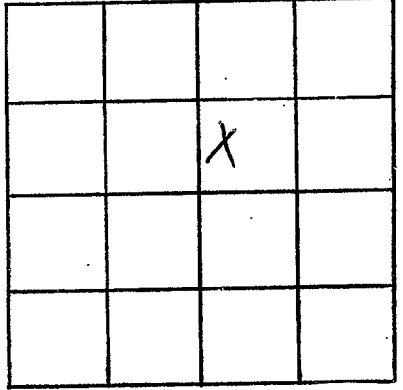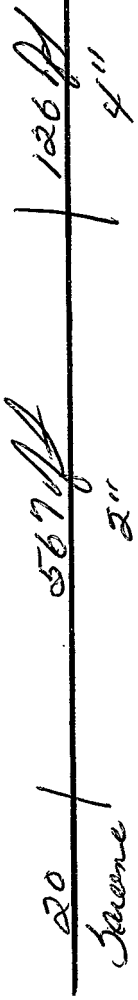

SECTION 19

Please indicate well location X.

ADDITIONAL INFORMATION

Lined area for additional information.

If more than one screen, show locations of each on sketch.