

MISSISSIPPI BOARD OF WATER COMMISSIONERS

~~RE-35~~ E28

8-26-65 WATER WELL DRILLERS LOG

CODED
SUNFLOWER

Date: April 19, 1965, Driller: Delta Wells Supply County: SUNFLOWER
(Name)

(1) Owner of Land: J. D. Harris
(Name)
R. F. D. Choudrouel
(Address)

(2) Location: 1/4, 1/4, Sec. 33 T4 R5 S1
5 miles East of Choudrouel
(distance) (direction) (Nearest Town)

(3) Topography: Level
(Hilly) (Flat) (Level)

(4) Purpose of Well: Domestic
(Domestic Irrigation, Municipal, Industrial, Other)

Description & Color of Materials Sand, Clay, Red Clay, Shell, etc.	Thick- ness Feet	Depth Feet
Top soil		20
Sand fine	38	50
u & gravel	65	115
Clay & shale	65	180
sand fine	35	215
shale	10	225
sand	75	300
shale	10	310
sand fine	30	340
clay	11	357
sand fine	34	385
shale	35	420
Rock	2	422
clay & shale	8	430
Rock	3	433
shale	3	436
Rock	1	437
clay shale	43	490
clay shale	50	540
Sand fine	65	605
Sand c.	20	625
shale	10	635
Sand	6.7	702
Clay		

Information upon completion of well:

(1) Diameter 6 1/2 inches.

(2) Total Depth 70.2 feet.

(3) Water Level 2.3 feet below top of ground.

(4) Cased to _____, Size _____

(5) Screen: Size 3", Length 30 ft.

(6) Were any formations sealed against pollution?
_____ yes, _____ no.

If YES depth of formation _____


Why _____

Drillers Remarks: _____

Yield in G. P. M.: 60

Type power: elec

Irrigated & Acreage: _____

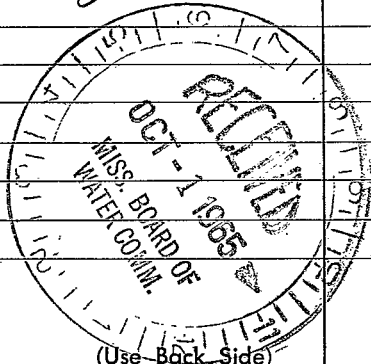

Well No.

100

100

100

100