

SUNFLOWER  
E 30  
8-15-80

MISSISSIPPI  
BOARD OF WATER COMMISSIONERS  
416 North State Street  
Jackson, Mississippi 39201  
CODED  
WATER WELL DRILLERS LOG

August 15 19 80 Bruce Berryman SUNFLOWER  
date well completed firm name county well located  
Greenwood.

| LANDOWNER: Mrs. Kent<br>Rt. 1. Box 183<br>Ruleville. MS 38771<br>(mailing address) | description of formations encountered | from | to  |
|--|---------------------------------------|------|-----|
|  | Clay                                  | 0    | 60  |
|  | Sand                                  | 60   | 80  |
|  | Sand & Gravel                         | 80   | 120 |
|  | Clay                                  | 120  | 140 |
|  | Sand                                  | 140  | 240 |
|  | Clay                                  | 240  | 290 |
|  | Sand                                  | 290  | 380 |
|  | Shale                                 | 380  | 560 |
|  | Rock 400' & 440'                      |      |     |
|  | Sand                                  | 560  | 620 |
|  | Clay                                  | 620  | 630 |

WELL LOCATION:

sec. 9 T. 2N R. 48 E  
3 miles NW. of Ruleville  
(distance) (direction) (nearest town)

WELL PURPOSE: Home  
(home, irrigation, municipal, industrial)

WELL COMPLETION DATA:

- (1) diameter (inches) 4" x 2"  
(2) total depth (feet) 618'  
(3) static water level (feet) 29' below top of ground - 126'  
(4) casing 2" galv. - 472'  
(material) (depth)

if telescope see back.  
(size)

- (5) screen 20' / 598'  
(length) (depth to top)  
.010 Stainless steel  
(size) (material)

- (6) pump 1 h.p. 15  
(HP) (yield gpm)  
Electric  
(type power)

- (7) electric log NO  
(yes or no)

(organization running log)

- (8) how well bottom plugged B.P.V.

DRILLERS REMARKS:


DEPT. OF NATURAL RESOURCES  
BUREAU OF LAND & WATER RESOURCES

SEP 30 1980

RECEIVED

If well telescopes please sketch and show depths.

GROUND LEVEL

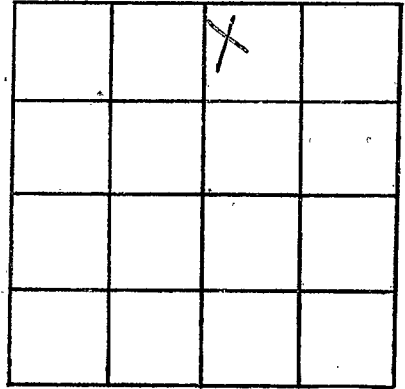

SECTION 9

Please indicate well location X.

ADDITIONAL INFORMATION

If more than one screen,  
show locations of each on sketch.