

MISSISSIPPI DEPARTMENT OF NATURAL RESOURCES

Bureau of Land and Water Resources

Southport Mall

P.O. Box 10631

Jackson, Mississippi 39209

WATER WELL DRILLERS LOG

MS-GW-08363
~~Sanborn~~
~~50~~

Used
 E31

4-27-88 date well completed
 Dyer Well firm name
 Sunflower county well located

LANDOWNER: Mr. Estel Morris
Rt 1 Box 36
Merigold, Mo. 38759
 (mailing address)

description of formations encountered

from	to
0	28
28	45
45	85
85	90
90	115

Clay
 7 Sand + 10 Clay
 Fine Sand
 Sand
 Sand + Gravel

WELL LOCATION:
 107C sec. 6 T. 22 N R. 4
15 miles SW of Drew
 (distance) (direction) (nearest town)

WELL PURPOSE: Irrigation
 (home, irrigation, municipal, industrial)

WELL COMPLETION DATA:

- (1) diameter (inches) 10"
- (2) total depth (feet) 115'
- (3) static water level (feet) _____ below above top of ground
- (4) casing steel, _____ (material), _____ (depth)
10 if telescope see back.
 (size)
- (5) screen 40, _____ (length), _____ (depth to top)
10, _____ (size), _____ (material)
- (6) pump 10, _____ (HP), _____ (yield gpm)
Elac
 (type power)
- (7) electric log No (yes or no)
None
 (organization running log)
- (8) how well bottom plugged Plate


RECEIVED
 MAY 02 1988

Department of Natural Resources
 Bureau of Land & Water Resources

DRILLERS REMARKS:

If well telescopes please
sketch and show depths.

GROUND LEVEL

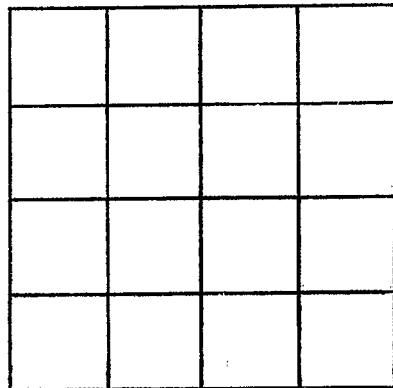

SECTION _____

Please indicate well location X.

ADDITIONAL INFORMATION

If more than one screen,
show locations of each on sketch.