

SUNFLOWER
E 51
1-15-75

MISSISSIPPI
BOARD OF WATER COMMISSIONERS
416 North State Street
Jackson, Mississippi 39201

CODED

WATER WELL DRILLERS LOG

1-15-75 19 75 UTANE GAS CO. OF GREENWOOD SUNFLOWER
date well completed firm name county well located

LANDOWNER:	description of fomations encountered	from	to
Dorothy Scott			
Ruleville, Miss.	SAND	25	60
(mailing address)	SAND + GRAVEL	60	83
WELL LOCATION:			
sec. <u>32</u> T <u>22</u> N R <u>4</u> E S W			
<u>4</u> miles <u>W</u> of <u>Ruleville</u> (distance) (direction) (nearest town)			
WELL PURPOSE: <u>Home</u> (home, irrigation, municipal, industrial)			
WELL COMPLETION DATA:			
(1) diameter (inches) <u>4</u> "			
(2) total depth (feet) <u>70</u>			
(3) static water level (feet) <u>18</u> above below ground.			
(4) casing <u>PVC</u> <u>60</u> (material) (depth) <u>4</u> " (size) if telescope see back.			
(5) screen <u>10'</u> <u>60</u> (length) (depth to top) <u>4"</u> <u>PVC</u> (size) (material)			
(6) pump <u>3/4</u> <u>15</u> (HP) (yield gpm) <u>Elec.</u> (type power)			
(7) electric log <u>✓</u> (yes or no)			
(organization running log)			
(8) how well bottom plugged <u>PVC cap</u>			
DRILLERS REMARKS:			


CODED

DEPARTMENT
JAN 31 1975

MISS. BD. OF WATER COMMISSIONERS

If well telescopes please sketch and show depths.

GROUND LEVEL

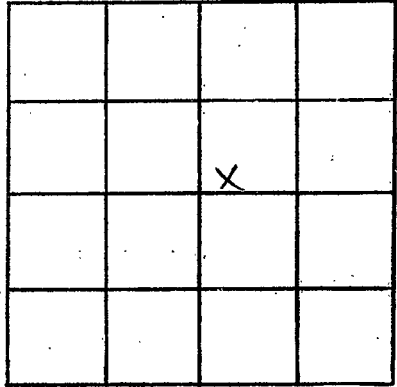

SECTION 32

Please indicate well location X.

ADDITIONAL INFORMATION

If more than one screen, show locations of each on sketch.