



If well telescopes please sketch and show depths.

GROUND LEVEL

Static Level

31'




124'



12" screen

40'

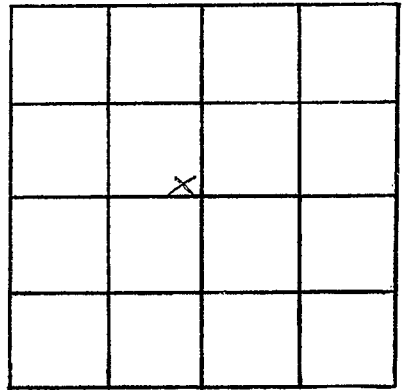

SECTION 30

Please indicate well location X.

ADDITIONAL INFORMATION

If more than one screen, show locations of each on sketch.