

MISSISSIPPI DEPARTMENT OF NATURAL RESOURCES

Bureau of Land and Water Resources

Southport Mall

P.O. Box 10631

Jackson, Mississippi 39209

WATER WELL DRILLERS LOG

CODED

CL-1745  
Sunflower  
E 61  
4-18-81

4-18  
 date well completed

19 81 LAYNE-CENTRAL COMPANY  
 firm name

Sunflower  
 county well located


LANDOWNER:	description of formations encountered	from	to
Summer Sollitt			
Ruleville, MS	brown sand	19	32
(mailing address)	doarse sand	32	55
WELL LOCATION:	coarse sand & pea gravel	55	84
sec. <u>24</u> T <u>22</u> N R <u>4</u> E	coarse sand & gravel	84	110
<u>2</u> miles <u>N-W</u> of <u>Ruleville</u>	coarse sand & boulders	110	118
(distance) (direction) (nearest town)			
WELL PURPOSE: irrigation			
(home, irrigation, municipal, industrial)			
WELL COMPLETION DATA:			
(1) diameter (inches) <u>32"</u>			
(2) total depth (feet) <u>118'</u>			
(3) static water level (feet) <u>30'6" below</u> top of ground.			
(4) casing <u>steel</u> <u>68'</u> (material) (depth)			
<u>16"</u> (size) If telescope see back.			
(5) screen <u>50'</u> <u>68'</u> (length) (depth to top)			
<u>16"</u> <u>st. steel</u> (size) (material)			
(6) pump <u>60</u> <u>2500</u> (HP) (yield gpm)			
<u>Diesel</u> (type power)			
(7) electric log <u>no</u> (yes or no)			
(organization running log)			
(8) how well bottom plugged <u>st. plate</u>			
DRILLERS REMARKS:			

CODED

DEPT. OF NATURAL RESOURCES  
 BUREAU OF LAND & WATER RESOURCES  
 RECEIVED  
 OCT 20 1981

If well telescopes please sketch and show depths.

GROUND LEVEL

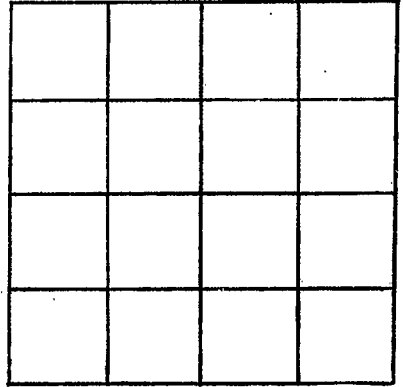

SECTION \_\_\_\_\_

Please indicate well location X.

ADDITIONAL INFORMATION

If more than one screen,  
show locations of each on sketch.