

MISSISSIPPI DEPARTMENT OF NATURAL RESOURCES

Bureau of Land and Water Resources

Southport Mall

P.O. Box 10631

Jackson, Mississippi 39209

WATER WELL DRILLERS LOG

CODED

*Anglo*  
EG4  
12/9/81

Dec. 09, 1981 date well completed *Larry's well & pump* firm name *Southport* county/well located

LANDOWNER: <i>Robert Andrews</i>	description of formations encountered	from	to
<i>Merigold mo.</i> (mailing address)	<i>MED &amp; FINE SAND</i>	<i>0</i>	<i>60</i>
WELL LOCATION: sec <i>3</i> T <i>22</i> N R <i>4</i> E <i>4</i> miles <i>W</i> of <i>Drew</i> (distance) (direction) (nearest town)	<i>COARSE SAND</i>	<i>60</i>	<i>100</i>
WELL PURPOSE: (home, irrigation, municipal, industrial)			
WELL COMPLETION DATA: (1) diameter (inches) <i>8"</i> (2) total depth (feet) <i>100'</i> (3) static water level (feet) <i>25</i> below above top of ground. (4) casing <i>PVC</i> , <i>60</i> (material) (depth) _____ if telescope see back. (size) (5) screen <i>40</i> <i>60</i> (length) (depth to top) <i>8"</i> , <i>PVC</i> (size) (material) (6) pump <i>10</i> <i>700</i> (HP) (yield gpm) <i>ELECT</i> (type power) (7) electric log <i>NO</i> (yes or no) _____ (organization running log) (8) how well bottom plugged <i>PVC</i> <i>cap</i>			
DRILLERS REMARKS:			


DEPT. OF NATURAL RESOURCES  
 BUREAU OF LAND & WATER RESOURCES

JAN 27 1982

RECEIVED

If well telescopes please sketch and show depths.

GROUND LEVEL

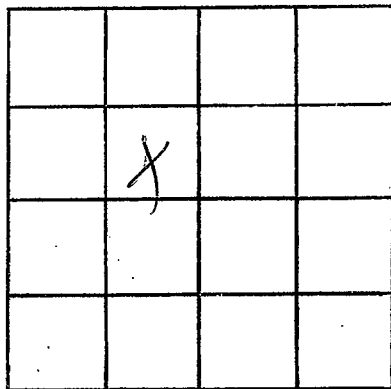

SECTION 3

Please indicate well location X.

ADDITIONAL INFORMATION

If more than one screen,  
show locations of each on sketch.