

MISSISSIPPI DEPARTMENT OF NATURAL RESOURCES

Bureau of Land and Water Resources

Southport Mall

P.O. Box 10631

Jackson, Mississippi 39209

WATER WELL DRILLERS LOG

CODED

Sunflower
E 65-
12/8/81

Dec 08

1981

Larry's Well & Pump

Sunflower

date well completed

firm name

county well located

LANDOWNER:

Haynes

description of formations encountered

from

to

Drew, Mo

(mailing address)

Clay
Fine Sand
Coarse Sand

0	40
40	60
60	100

WELL LOCATION:

sec. 4-T-22N

R-4E

5 miles W. of Drew
(distance) (direction) (nearest town)

WELL PURPOSE:

(home, irrigation, municipal, industrial)

WELL COMPLETION DATA:

- (1) diameter (inches) 8"
- (2) total depth (feet) 100'
- (3) static water level (feet) 24 below above top of ground.
- (4) casing PVC, 60'
(material) (depth)
 if telescope see back.
(size)
- (5) screen 40', 60'
(length) (depth to top)
8", PVC
(size) (material)
- (6) pump 10, 700
(HP) (yield gpm)
Elect
(type power)
- (7) electric log NO
(yes or no)

(organization running log)

- (8) how well bottom plugged PVC
cap

DRILLERS REMARKS:


DEPT. OF NATURAL RESOURCES
BUREAU OF LAND & WATER RESOURCES

JAN 27 1982

RECEIVED

If well telescopes please sketch and show depths.

GROUND LEVEL

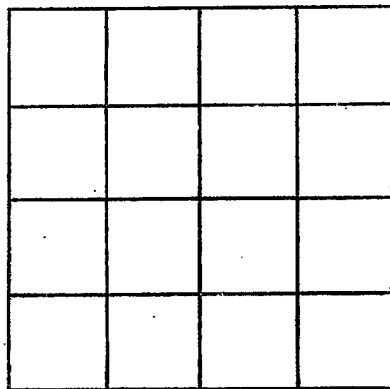

SECTION _____

Please indicate well location X.

ADDITIONAL INFORMATION

If more than one screen,
show locations of each on sketch.