

MISSISSIPPI DEPARTMENT OF NATURAL RESOURCES

Bureau of Land and Water Resources

Southport Mall

P.O. Box 10631

Jackson, Mississippi 39209

WATER WELL DRILLERS LOG

CODED

Sunflower
E 66
12/9/81

date well completed Dec 09 1981 firm name Larry's Well & Pump county well located Sunflower


LANDOWNER: <u>Robert Andrews</u>	description of formations encountered	from	to
<u>Merigold, Ms.</u> (mailing address)	<u>CLAY</u>	<u>0</u>	<u>70</u>
WELL LOCATION: sec. <u>4</u> T. <u>22</u> N R. <u>4</u> E <u>5</u> miles <u>W</u> of <u>Drew</u> (distance) (direction) (nearest town)	<u>FINE SAND</u>	<u>70</u>	<u>85</u>
WELL PURPOSE: (home, irrigation, municipal, industrial)	<u>MED + COARSE SAND</u>	<u>85</u>	<u>115</u>
WELL COMPLETION DATA: (1) diameter (inches) <u>8"</u>			
(2) total depth (feet) <u>115'</u>			
(3) static water level (feet) <u>23</u> below above top of ground.			
(4) casing <u>PVC</u> <u>85'</u> (material) (depth)			
_____ if telescope see back. (size)			
(5) screen <u>30</u> <u>95'</u> (length) (depth to top)			
_____ <u>8"</u> _____ <u>PVC</u> (size) (material)			
(6) pump <u>10</u> <u>700</u> (HP) (yield gpm)			
_____ <u>ELECT</u> (type power)			
(7) electric log <u>NO</u> (yes or no)			
_____ (organization running log)			
(8) how well bottom plugged <u>PVC</u> <u>cap</u>			
DRILLERS REMARKS: _____			

DEPT. OF NATURAL RESOURCES
 BUREAU OF LAND & WATER RESOURCES

JAN 27 1982
 RECEIVED

If well telescopes please sketch and show depths.

GROUND LEVEL

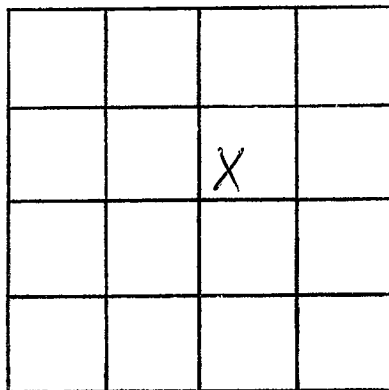

SECTION 4

Please indicate well location X.

ADDITIONAL INFORMATION

RECEIVED

82 JAN 27 A 8: 27

If more than one screen, show locations of each on sketch.