

MISSISSIPPI DEPARTMENT OF NATURAL RESOURCES

Bureau of Land and Water Resources

Southport Mall

P.O. Box 10631

Jackson, Mississippi 39209

WATER WELL DRILLERS LOG

CODED 17

Sumflow
 E 68
 6/18/82

6-18 19 82 *Super Well* *Sumflow*
 date well completed firm name county well located


LANDOWNER: <i>AC. De Lore</i>	description of formations encountered	from	to
(mailing address)	<i>Clay</i>	<i>0</i>	<i>18</i>
WELL LOCATION: sec. <i>3</i> T <i>22</i> N R <i>4</i> E <i>S</i> <i>W</i>	<i>fine Sand</i>	<i>18</i>	<i>28</i>
4 miles W of <i>Drew</i> (distance) (direction) (nearest town)	<i>Sand</i>	<i>28</i>	<i>58</i>
WELL PURPOSE: (home, irrigation) municipal, industrial	<i>Sand & gravel</i>	<i>58</i>	<i>110</i>
WELL COMPLETION DATA:			
(1) diameter (inches) <i>16</i>			
(2) total depth (feet) <i>110</i>			
(3) static water level (feet) <i>14</i> below above top of ground.			
(4) casing <i>Steel</i> , <i>80</i> <i>70</i> (material) (depth)			
<i>16</i> If telescope see back. (size)			
(5) screen <i>40</i> , <i>70</i> (length) (depth to top)			
<i>16</i> <i>Mild Steel</i> (size) (material)			
(6) pump <i>60</i> <i>3000</i> (HP) (yield gpm)			
<i>Diesel</i> (type power)			
(7) electric log <i>No</i> (yes or no)			
(organization running log)			
(8) how well bottom plugged <i>Plate</i>			
DRILLERS REMARKS:			

DEPT. OF NATURAL RESOURCES
 BUREAU OF LAND & WATER RESOURCES

SEP 30 1982
 RECEIVED

If well telescopes please sketch and show depths.

GROUND LEVEL

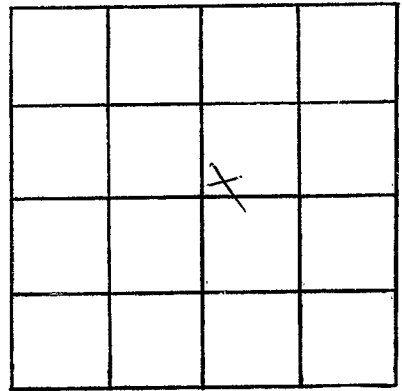

SECTION 1

Please indicate well location X.

ADDITIONAL INFORMATION

If more than one screen,
show locations of each on sketch.