

MISSISSIPPI DEPARTMENT OF NATURAL RESOURCES

Bureau of Land and Water Resources

Southport Mall

P.O. Box 10631

Jackson, Mississippi 39209

WATER WELL DRILLERS LOG

Sunflower
E70

6222

5-23-86 19 IRrigation Equipment Sunflower
 date well completed firm name county well located


LANDOWNER: Sunflower Co.
Board of Education Box 70
INDIANOLA, MS 38751
 (mailing address)

description of formations encountered	from	to
<u>clay</u>	<u>0</u>	<u>10</u>
<u>fine sand</u>	<u>10</u>	<u>55</u>
<u>coarse sand/pea gravel</u>	<u>55</u>	<u>105</u>

WELL LOCATION:
 sec. 16 T. 22 N. R. 4 E
4 miles NORTH of Dockery
 (distance) (direction) (nearest town)

WELL PURPOSE: RICE
 (home, irrigation, municipal, industrial)

- WELL COMPLETION DATA:
- (1) diameter (inches) 10"
 - (2) total depth (feet) 105'
 - (3) static water level (feet) 30' below above top of ground.
 - (4) casing PVC 65'
 (material) (depth)
10" if telescope see back.
 (size)
 - (5) screen 40 65'
 (length) (depth to top)
10" PVC
 (size) (material)
 - (6) pump 40 1800
 (HP) (yield gpm)
Diesel
 (type power)
 - (7) electric log NO
 (yes or no)
 (organization running log) PVC CAP
 - (8) how well bottom plugged PVC CAP

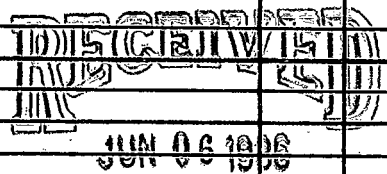


Department of Natural Resources
 Bureau of Land & Water Resources

DRILLERS REMARKS:
86121 MG501
MS-GW 3685

If well telescopes please sketch and show depths.

GROUND LEVEL

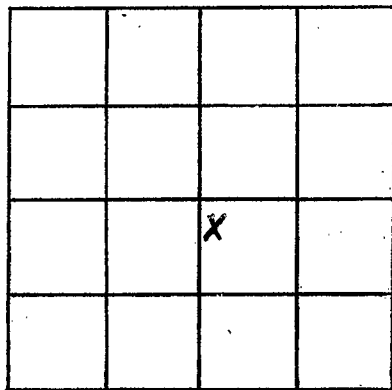

SECTION 16

Please indicate well location X.

ADDITIONAL INFORMATION

If more than one screen,
show locations of each on sketch.