

MISSISSIPPI DEPARTMENT OF NATURAL RESOURCES

Bureau of Land and Water Resources

Southport Mall

P.O. Box 10631

Jackson, Mississippi 39209

WATER WELL DRILLERS LOG

CODED

SUNFLOWER
E 71

APRIL 1986 date well completed COOK Drilling Co firm name Sunflower county well located

LANDOWNER:	description of formations encountered	from	to
Jimmy Barrett Cleveland Miss (mailing address)	Clay sand & gravel sand & gravel Clay	Top	15' 65' 120'
WELL LOCATION: sec. 30 T 22 N R 4 E 5 miles 2 of Cleveland (distance) (direction) (nearest town)			
WELL PURPOSE: Irrigation (home, irrigation, municipal, industrial)			
WELL COMPLETION DATA:			
(1) diameter (inches) 16"			
(2) total depth (feet) 128'			
(3) static water level (feet) 75" below top of ground.			
(4) casing Steel 78' (material) (depth) 16" (size) if telescope see back.			
(5) screen 40' (length) 78' (depth to top) 16" (size) Steel (material)			
(6) pump 20 (HP) 1500 (yield gpm) E/oz (type power)			
(7) electric log no (yes or no) (organization running log)			
(8) how well bottom plugged Poth			
DRILLERS REMARKS:			

CODED


RECEIVED

SEP 29 1986

Department of Natural Resources
Bureau of Land & Water Resources

If well telescopes please
sketch and show depths.

GROUND LEVEL

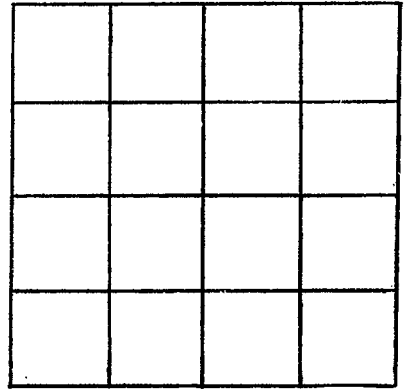

SECTION 22

Please indicate well location X.

ADDITIONAL INFORMATION

If more than one screen,
show locations of each on sketch.