

MISSISSIPPI DEPARTMENT OF NATURAL RESOURCES

Bureau of Land and Water Resources

Southport Mall

P.O. Box 10631

Jackson, Mississippi 39209

WATER WELL DRILLERS LOG

CODE

SUNFLOWER
E 72

APR 1 1986 date well completed COOK Drilling firm name Benton county well located

LANDOWNER:	description of formations encountered	from	to
<u>Gant & Son</u>	<u>Plm</u>	<u>top</u>	<u>40'</u>
<u>Cleveland Miss</u> (mailing address)	<u>7' sand</u>	<u>40'</u>	<u>60'</u>
WELL LOCATION:	<u>sand & gravel</u>	<u>60'</u>	<u>110'</u>
sec. <u>17</u> T <u>22</u> N R <u>4</u> E S W	<u>Plm</u>		
<u>6</u> miles <u>W</u> of <u>Prue</u> (distance) (direction) (nearest town)			
WELL PURPOSE: Private (home, irrigation, municipal, industrial) <u>2156</u>			
WELL COMPLETION DATA:			
(1) diameter (inches) <u>16"</u>			
(2) total depth (feet) <u>170'</u>			
(3) static water level (feet) <u>38'</u> below top of ground.			
(4) casing <u>Steel</u> , <u>70'</u> (material) (depth) <u>16"</u> if telescope see back. (size)			
(5) screen <u>40'</u> , <u>580'</u> (length) (depth to top)			
(6) pump <u>16"</u> , <u>Steel</u> (size) (material)			
(7) pump <u>30</u> , <u>1600</u> (HP) (yield gpm)			
<u>Plm</u> (type power)			
(7) electric log <u>no</u> (yes or no)			
(organization running log)			
(8) how well bottom plugged			
DRILLERS REMARKS:			

CODE


RECEIVED

SEP 29 1986

Department of Natural Resources
 Bureau of Land & Water Resources

If well telescopes please sketch and show depths.

GROUND LEVEL

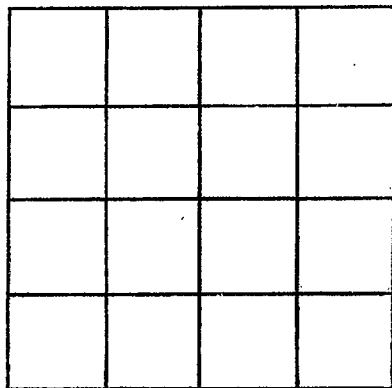

SECTION 17

Please indicate well location X.

ADDITIONAL INFORMATION

If more than one screen,
show locations of each on sketch.