

MISSISSIPPI DEPARTMENT OF NATURAL RESOURCES

Bureau of Land and Water Resources

COUNTY WELL LOCATED
Sunflower

WELL NUMBER
E-74

CODED

DATE WELL COMPLETED
7-88

PERMIT NUMBER

NAME OF DRILLING FIRM
*Rowell Drilling, Inc
Rt 2 Box 208
Clarksdale, MS*

CODEN

P.O. Box 10631

Jackson, Mississippi 39209

WATER WELL DRILLERS LOG

NAME & MAILING ADDRESS OF LANDOWNER
A.C. Tidmore

Rt 1

Merigold, MS

WELL LOCATION: SEC *34* TOWNSHIP *22* RANGE *N 4 W*

DISTANCE *3* Miles DIRECTION *W* of NEAREST TOWN *Drew*

OTHER LANDMARK

WELL PURPOSE: Home Irrigation, Municipal, Industrial, Fish Pond, etc.

PUMP DATA

PUMP TYPE (Circle One):
 Submersible, Turbine, Jet, Flowing Well,
Other (Describe) _____

POWER TYPE (Circle One):
 Electric, Tractor, Diesel, Gasoline, Butane,
Other (Describe) _____

Pump Capacity (GPM) *900* No. of Stages *1* Setting Depth *50'* FT.

PUMP TEST

Well yielded *900* GPM with
a drawdown of _____ ft.
after _____ hours of pumping

WELL DATA

Well Depth <i>100'</i>	Casing Diameter (In) <i>10"</i>	Casing Length (Ft.) <i>60</i>
Type of Casing <i>PVC</i>	Hole Depth <i>100'</i>	Depth to Static Water Level <i>16'</i>

TYPE OF COMPLETION: (Circle One or More):
 Gravel Packed, Underreamed, Telescoped,
 Natural Development, Open Hole, Other

Top of Lap Pipe or Reduction in Casing

FEET IF TELESCOPED OR MORE THAN ONE SCREEN: USE BACK PAGE

LOG DATA

TYPE OF LOG RUN (Circle One):
 No Log Run, Electric, Gamma Ray, Density, Sonic, Neutron,
Other (Describe) _____

Name of Organization Running Log

SCREEN DATA

Diameter - Inches <i>10"</i>	Length - Feet <i>40</i>	Slot Size - Inches <i>.030</i>
Screen Type <i>PVC</i>	Depth to Bottom - Feet <i>100'</i>	

GEOLOGIC DATA (Office Use Only)

Surface Elev.	Geologic Unit	Unit Thickness	Depth to Top
Subs. SWL	Date	Analysis	Aquifer Test

Driller's Remarks

DESCRIPTION OF FORMATIONS ENCOUNTERED	FROM	TO
<i>Clay</i>	<i>0</i>	<i>20</i>
<i>Fine Sand</i>	<i>20</i>	<i>40</i>
<i>Coarse sand + gravel</i>	<i>40</i>	<i>100</i>

RECEIVED


SEP 22 1988

Department of Natural Resources
Bureau of Land & Water Resources

IF MORE SPACE IS NEEDED, USE BACK

If well telescopes please sketch and show depths.

GROUND LEVEL

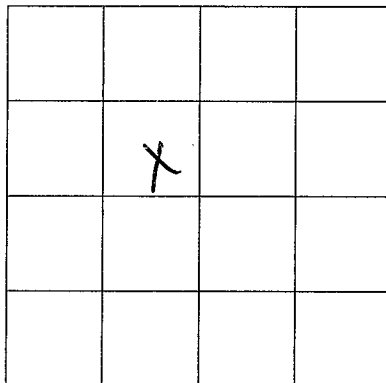

SECTION 34

Please indicate well location X.

ADDITIONAL INFORMATION

If more than one screen,
show location of each on sketch.