

22-4336

MISSISSIPPI DEPARTMENT OF NATURAL RESOURCES

Bureau of Land and Water Resources

COUNTY WELL LOCATED  
Sunflower

WELL NUMBER E 75 CODED

DATE WELL COMPLETED  
8-16-89

107D

PERMIT NUMBER  
89227CM601

NAME OF DRILLING FIRM  
Lagne - Central Co

Cleveland, MS

**CODED**

P.O. Box 10631

Jackson, Mississippi 39209

WATER WELL DRILLERS LOG

NAME & MAILING ADDRESS OF LANDOWNER  
Woodard Eubanks

Boyles Dairy Road

Ruleville, MS 38771

WELL LOCATION: SEC 24 TOWNSHIP 22 RANGE 4  N  W

DISTANCE 4 Miles DIRECTION N/W NEAREST TOWN of Ruleville

OTHER LANDMARK

WELL PURPOSE: Home,  Irrigation, Municipal, Industrial, Fish Pond, etc.

PUMP DATA

PUMP TYPE (Circle One):  
 Submersible, Turbine, Jet, Flowing Well,  
Other (Describe) \_\_\_\_\_

POWER TYPE (Circle One):  
 Electric, Tractor, Diesel, Gasoline, Butane,  
Other (Describe) \_\_\_\_\_ H/P \_\_\_\_\_

Pump Capacity (GPM) 1000 No. of Stages 1 Setting Depth 60 FT.

PUMP TEST

Well yielded NOT TESTED GPM with  
a drawdown of \_\_\_\_\_ ft.  
after \_\_\_\_\_ hours of pumping

WELL DATA

|                              |                                     |   |
|------------------------------|-------------------------------------|---|
| Well Depth<br><u>98'</u>     | Casing Diameter (In.)<br><u>10"</u> | Casing Length (Ft.)<br><u>60</u>          |
| Type of Casing<br><u>PVC</u> | Hole Depth<br><u>98'</u>            | Depth to Static Water Level<br><u>39'</u> |

TYPE OF COMPLETION: (Circle One or More):  
 Gravel Packed,  Underreamed,  Telescoped,  
 Natural Development,  Open Hole,  Other

Top of Lap Pipe or Reduction in Casing  
FEET  IF TELESCOPED OR MORE THAN ONE SCREEN: USE BACK PAGE

LOG DATA

TYPE OF LOG RUN (Circle One):  
Electric, Gamma Ray, Density, Sonic, Neutron,  
Other (Describe) \_\_\_\_\_

Name of Organization Running Log

SCREEN DATA

|                                |                                     |                                   |
|--------------------------------|-------------------------------------|-----------------------------------|
| Diameter - Inches<br><u>10</u> | Length - Feet<br><u>40</u>          | Slot Size - Inches<br><u>.056</u> |
| Screen Type<br><u>PVC</u>      | Depth to Bottom - Feet<br><u>98</u> |                                   |

GEOLOGIC DATA (Office Use Only)

|               |               |                |              |
|---------------|---------------|----------------|--------------|
| Surface Elev. | Geologic Unit | Unit Thickness | Depth to Top |
| Subs. SWL     | Date          | Analysis       | Aquifer Test |

Driller's Remarks

| DESCRIPTION OF FORMATIONS ENCOUNTERED | FROM      | TO         |
|---------------------------------------|-----------|------------|
| <u>CLAY</u>                           | <u>0</u>  | <u>19</u>  |
| <u>SAND</u>                           | <u>19</u> | <u>45</u>  |
| <u>SAND &amp; GRAVEL</u>              | <u>45</u> | <u>98</u>  |
| <u>CLAY</u>                           | <u>98</u> | <u>100</u> |
|                                       |           |            |
|                                       |           |            |
FORMATIONS (Continued) FROM TO

**RECEIVED**

**SEP 22 1989**


Department of Natural Resources  
Bureau of Land & Water Resources

IF MORE SPACE IS NEEDED, USE BACK

If well telescopes, please  
sketch and show depths.

---

GROUND LEVEL

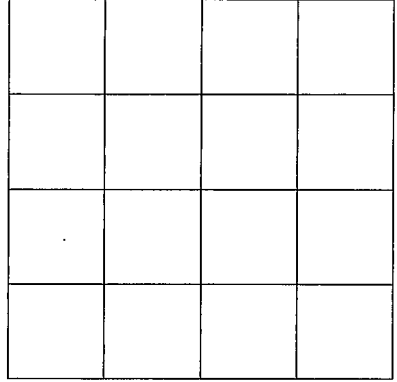

SECTION \_\_\_\_\_

Please indicate well location X.

---

ADDITIONAL INFORMATION

---

If more than one screen,  
show location of each on sketch.

---