

33-46-42 90-36-05

MISSISSIPPI DEPARTMENT OF ENVIRONMENTAL QUALITY

Office of Land and Water Resources

COUNTY WELL LOCATED
Sunflower

WELL NUMBER **E-88** CODED

DATE WELL COMPLETED
6-27-01

PERMIT NUMBER

NAME OF DRILLING FIRM
Irrigation Equipment Inc.

Indianola, MS

P. O. Box 10631
Jackson, MS 39289-0631
WATER WELL DRILLERS LOG

NAME & MAILING ADDRESS OF LANDOWNER
**George Moody/Garner Falls
Box 112**

Minter City, MS 38944

Latitude:
Longitude:

WELL LOCATION. SEC TOWNSHIP RANGE
se/nw 15 22N N 4W E W

DISTANCE DIRECTION NEAREST TOWN
Miles **SW Drew**

OTHER LANDMARK

WELL PURPOSE: Home, Irrigation, Municipal, Industrial, Fish Pond, etc.
Irrigation Pivot

PUMP DATA

PUMP TYPE (Circle One):
Submersible, **Turbine** Jet Flowing Well,
Other (Describe)

POWER TYPE (Circle One):
Electric, Tractor, **Diesel** Gasoline, 60 Butane,
Other (Describe) H/P

DESCRIPTION OF FORMATIONS ENCOUNTERED	FROM	TO
Clay	0	28
Fine Sand	28	78
Med. Sand/gravel	78	110

WELL DATA

Well Depth 110	Casing Diameter (In.) 16	Casing Length (Ft.) 78
Type of Casing pvc	Hole Depth 110	Depth to Static Water Level 39ft.

TYPE OF COMPLETION: (Circle One or More):
Gravel Packed Underreamed, Telescoped,
Natural Development, Open Hole, Other
(Describe)

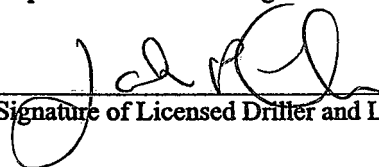
WELL GROUTED TO A DEPTH OF _____ FEET
Type Grout (circle one): Cement, Bentonite, or Mix

SCREEN DATA

Diameter - Inches 16	Length - Feet 32	Slot Size - Inches .050
Screen Type pvc	Depth to Bottom - Feet 110	

Top of Lap Pipe or Reduction in Casing
FEET IF TELESCOPED OR MORE THAN ONE SCREEN: USE BACK PAGE

I certify that the well was drilled, constructed and completed in accordance with all applicable Requirements of the Mississippi Department of Environmental Quality and/or the Mississippi Department of Health regulations and state laws.


Signature of Licensed Driller and License No.

0-439
Date

REC'D SEP-24 2001

If well telescopes please sketch and show depths.

GROUND LEVEL

	X		

SECTION 15

Please indicate well location X.

Pump Capacity (GPM)	No. of Stages	Setting Depth
900	3	60 FT.

PUMP TEST

Well yielded _____ GPM with
 a drawdown of _____ ft.
 after _____ hours of pumping

LOG DATA

TYPE OF LOG RUN (Circle One): No Log Run,
 Electric, Gamma Ray, Density, Sonic, Neutron,
 Other (Describe) _____

Name of Organization Running Log

GEOLOGIC DATA (Office Use Only)

Surface Elev.	Geologic Unit	Unit Thickness	Depth to Top
Subs. SWL	Date	Analysis	Aquifer Test

Driller's Remarks

If more than one screen,
 show location of each on sketch.