	State W	Vell Report	
County: Sunflower	I	Part 1	For Office Use Only:
Permit #: 6. 6. 41 549		nt of Environmental Quality and Water Resources	Aquifer:
Irrigation Equipment		Box 10631	Well #:///
Driller:8_2_05	-	MS 39289-0631	L. S. Elevation:
Date drilling completed: 8-2-05)961-5210 54-6938 (fax)	E-log #:
State Law requires that this rep 30 days of completion of drilling		e driller in detail and filed w	ng the Department within
Well Owner Informa		Wel	Location
Owner Name Mike Shepher	d	Latitude:	" Longitude:'
Mailing Address: 48 Shepherd	Road	Method of Lat/Long (circle or	e): Conventional Survey.
muning / mulcas > *** -			•
		-	GPS, Survey-grade GPS
Merigold, M	S 38759	<u>NE 1/4 NE 1/4 Sec 4</u>	TwnZZN_Rng_4W
City Sta	te Zip Code	Distance Direction	Nearest Town
Telephone No. (662-745-267	1	5 Miles West	
			<u>NLULII</u>
	Well	Data	1 1 200
Purpose of Well (circle one) Home Ind	ustrial Public Supply	Inigation Fish Culture	Other: AUG 11 200
Date well drilling started: <u>8-2</u>	-05 Date	well drilling completed:	8-2-2-05 JOINT WA
If flowing, method of flow regulation: Val	lve Other (a	describe)	MANAGEMENT D
Static Water Level:feet ab		land aufras - Data maamindi	8-3-05
Method of Measurement (circle one)	cel tape electric tape	e air line other.	<u> </u>
Hole depth: <u>126</u> Well dep	oth: <u>126'</u>	_ Well grouted to a depth of	fcet
Type of grout (circle one): Cement	Bentonite Mix		
Casing length: 86 feet Casin	ng diameter: 16	inches Type of casing:	PVC Sch.40
			PVC Sch.40
Screen length: <u>40</u> feet Scre	en diameter: 16	inches Type of screen:	PVC Sch.40
Screen length: <u>40</u> feet Scre	en diameter: 16	inches Type of screen:	PVC Sch.40
Screen length: <u>40</u> feet Scree Screen slot size: <u>050</u> inches	en diameter: 16 Setting depth: From		PVC Sch. 40
Screen length: <u>40</u> feet Scree Screen slot size: <u>050</u> inches	en diameter: 16 Setting depth: From _ Gravel packed Unde		PVC Sch. 40 <u>126</u> feet hole Natural Development
Screen length: <u>40</u> feet Screen Screen slot size: <u>050</u> inches Type of completion (circle all applicable):	en diameter: 16 Setting depth: From _ Gravel packed Unde Other (describe):	inches Type of screen: 87feet to meamed Telescoped Open	PVC Sch. 40 <u>126</u> feet hole Natural Development
Screen length: <u>40</u> feet Screen Screen slot size: <u>050</u> inches Type of completion (circle all applicable):	en diameter: 16 Setting depth: From _ Gravel packed Unde Other (describe):feet. If te	inches Type of screen:	PVC Sch. 40 <u>126</u> feet hole Natural Development een, describe on back of page
Screen length: <u>40</u> feet Screen Screen slot size: <u>050</u> inches Type of completion (circle all applicable):	en diameter: 16 Setting depth: From _ Gravel packed Unde Other (describe):feet. If te	inches Type of screen:	PVC Sch. 40 <u>126</u> feet hole Natural Development een, describe on back of page
Screen length: <u>40</u> feet Screen Screen slot size: <u>050</u> inches Type of completion (circle all applicable): Top of lap pipe or reduction in casing: <u>100</u> Logs run (circle all applicable): No log run	en diameter: 16 Setting depth: From Gravel packed Unde Other (describe): feet. If to h Electric Gamma Ray	inches Type of screen:	PVC Sch. 40 <u>126</u> feet hole Natural Development cen, describe on back of page Other:
Screen length: <u>40</u> feet Screen Screen slot size: <u>050</u> inches Type of completion (circle all applicable): Top of lap pipe or reduction in casing: Logs run (circle all applicable): No log run Name of organization running log(s): I certify that the well was drilled, constr	en diameter: 16 Setting depth: From _ Gravel packed Unde Other (describe):feet. If te h Electric Gamma Ray	inches Type of screen: feet to rreamed Telescoped Open elescoped or more than one scr y Density Sonic Neutron accordance with all applicable	PVC Sch. 40 <u>126</u> feet hole Natural Development een, describe on back of page Other: requirements of the Mississip
Screen length: <u>40</u> feet Screen Screen slot size: <u>050</u> inches Type of completion (circle all applicable): Top of lap pipe or reduction in casing: Logs run (circle all applicable): No log run Name of organization running log(s): I certify that the well was drilled, constr Department of Environmental Quality a	en diameter: 16 Setting depth: From Gravel packed Unde Other (describe): feet. If to h Electric Gamma Ray ucted, and completed in and/or the Mississippi De	inches Type of screen: feet to rreamed Telescoped Open elescoped or more than one scr y Density Sonic Neutron accordance with all applicable	PVC Sch. 40 <u>126</u> feet hole Natural Development een, describe on back of page Other: requirements of the Mississip
Screen length: <u>40</u> feet Screen Screen slot size: <u>050</u> inches Type of completion (circle all applicable): Top of lap pipe or reduction in casing: Logs run (circle all applicable): No log run Name of organization running log(s): I certify that the well was drilled, constr	en diameter: 16 Setting depth: From Gravel packed Unde Other (describe): feet. If to h Electric Gamma Ray ucted, and completed in and/or the Mississippi De	inches Type of screen: feet to rreamed Telescoped Open elescoped or more than one scr y Density Sonic Neutron accordance with all applicable	PVC Sch. 40 <u>126</u> feet hole Natural Development een, describe on back of page Other: requirements of the Mississip


40549

If well telescopes please sketch below and show depths.

Ground Level

Description of Formations Encountered	From To
Clay	0 70
Fino Sand	71 76
Fine Sand Med. Sand/gravel	77126
Med. Sand/gravel	

If more than one screen, show location of each on sketch

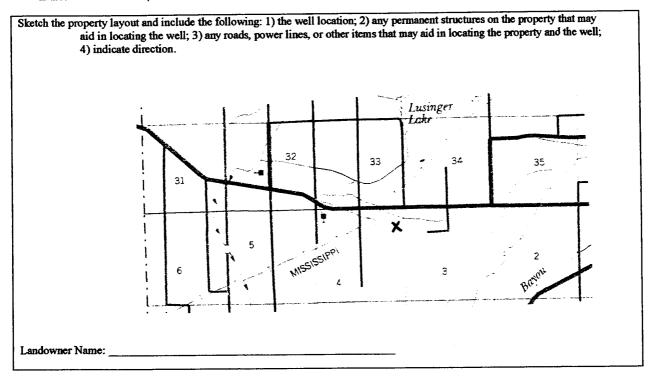

Signature of Water Well Contractor

E-111

,

	STATE WELL REPORT	
County: Sunflower	Part 2 Pump Installer's Completion Report	For Office Use Only:
Permit# <u>(20) 4054</u> 9 Irrigation Equipment Driller:	Mississippi Department of Environmental Quality Office of Land and Water Resources P.O. Box 10631 Justices MS 20290 0621	Aquifer:
Date completed: $8-3-05$	Jackson, MS 39289-0631 (601)961-5210 (601)354-6938 (fax)	Elevation:

This report should be prepared by the pump installer in	n detail and filed with the Department within 30 days of the
installation of pump.	
W.11 O L.C	Wall Location

weil Owner Information	well Location	
Owner Name: Mike Shepherd	Latitude:Longitude:	
Mailing Address: 48 Shepherd Road	Method of Lat/Long (circle one): Conventional Survey,	
Merigold, MS 38759 City State Zip Code	USGS quad, Hand-held GPS, Survey-grade GPS $4 _{4} _{4} _{4} _{4} _{4} _{4} _{4} _{4$	
662-745-2671 Telephone No. ()	Distance Direction Nearest Town 5 _{Miles} West _{of} Drew	

Pump Type Circle one			Power Type Circle one		
Air Lift	Jet	Submersible	Diesel Engine	Gasoline Engine	Natural Gas
Bucket	Piston	Turbine	Electric Motor	Hand	Tractor PTO
Centrifugal	Rotary	Flowing Well	Windmill	Other (specify):	
Other (specify):			Horse Power Ratin	g of Motor:60	
Date Pump Installed:		-3-05	Setting Depth:	70	feet
Rated Pump Capacity	2500-300) () Gallons Per Minute	Number of Stages:	1	

Pump Test Data	Method of Measuring Water Level Circle one
Date Well Tested:	
Static Water Level (A):Feet Below Land Surface	Air Line Electric Measuring Line Steel Tape
Pumping Water Level (B):Feet Below Land Surface	Other (specify):
Drawdown [(B) – (A)]:Feet Below Land Surface	For flowing well, measured shut in head:feet
Test Pumping Rate:Gallons Per Minute	Well yielded GPM with a drawdown of
Duration of Pump Test (minimum 4 hours):hours	feet afterhours of pumping

I HEREBY CERTIFY that the above statements are true to the bes	st of my knowledge.	
Patrick M. Chism 0695	Patrick M Chin	
Print Name of Pump Installer and License No. (if applicable)	Signature of Pump Installer	
		RECEIVED

AUG + 2 2005 BY: OLVVR