

Surflower
 E 2000
 1-5-76

MISSISSIPPI
 BOARD OF WATER COMMISSIONERS
 416 North State Street
 Jackson, Mississippi 39201

WATER WELL DRILLERS LOG

Surflower
Bolton

1-5 1976 *Bolton Well & Supply* county well located


LANDOWNER: *Tra L Stewart*
Cleveland, Miss
 (mailing address)

WELL LOCATION:
 sec. 18 T 22 N R 4 E
4 mi miles N-E of Cleveland
 (distance) (direction) (nearest town)

WELL PURPOSE: Home
 (home, irrigation, municipal, industrial)

- WELL COMPLETION DATA:
- (1) diameter (inches) 4" x 2"
 - (2) total depth (feet) 693
 - (3) static water level (feet) 23 below above top of ground.
 - (4) casing 4 x 3 galv pipe
 (material) (depth)
 - _____ If telescope see back.
 (size)
 - (5) screen 20' _____
 (length) (depth to top)
 - 2" _____
 (size) (material)
 - (6) pump 1 20
 (HP) (yield gpm)
 - Elec.
 (type power)
 - (7) electric log No
 (yes or no)
 - _____ (organization running log)
 - (8) how well bottom plugged BP Valve

description of formations encountered	from	to
Top soil	0	23
Sand (fine)	28	53
Sand & gravel	55	147
Clay	147	330
Sand	330	385
Clay	385	490
Sand	490	518
Shale & Clay	518	625
Good sand	625	714
Set at		693

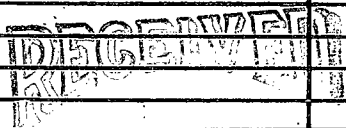

FEB 10 1976

DRILLERS REMARKS:

MISS. BD. OF WATER COMAN

