

*Sunflower*  
 E 2001  
 1-15-76

MISSISSIPPI  
 BOARD OF WATER COMMISSIONERS  
 416 North State Street  
 Jackson, Mississippi 39201

WATER WELL DRILLERS LOG

*Sunflower*  
~~Bohner~~

1-15 1976  
 date well completed

26 Delta Well + Supply  
 firm name

county well located

LANDOWNER: *Otis Hill*  
*Cleveland, Miss*  
 (mailing address)  
 WELL LOCATION:  
 sec. 30 T. 22 N. R. 4 E  
3 1/2 miles East of Cleveland  
 (distance) (direction) (nearest town)

description of formations encountered	from	to
Top soil	0	17
fine sand	17	43
Coarse sand	43	95
Pea gravel	95	118
Clay	118	310
Coarse sand	310	400
Clay	400	465
Sand	465	495
Clay	495	622
Good sand	622	726
slt at		715

WELL PURPOSE: *Home & shop*  
 (home, irrigation, municipal, industrial)

WELL COMPLETION DATA:  
 (1) diameter (inches) 4" x 2"  
 (2) total depth (feet) 715  
 (3) static water level (feet) 40 below above top of ground.  
 (4) casing 4" x 2" galv. (material), (depth)  
 (size) If telescope see back.  
 (5) screen 20 (length), (depth to top)  
2" (size), stainless steel (material)  
 (6) pump 1 (HP), 20 (yield gpm)  
Elec. (type power)  
 (7) electric log no (yes or no)  
 (organization running log)  
 (8) how well bottom plugged B.P. Valve


RECEIVED  
 FEB 10 1976

MISS. BD. OF WATER COMM

DRILLERS REMARKS:

If well telescopes please sketch and show depths.

GROUND LEVEL

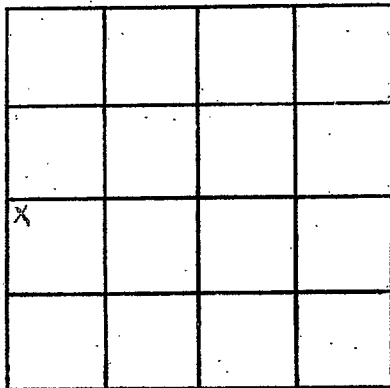

SECTION 30

Please indicate well location X.

ADDITIONAL INFORMATION

Horizontal lines for additional information.

If more than one screen, show locations of each on sketch.