

SUNFLOWER

E 200

04-02-79

MISSISSIPPI BOARD OF WATER COMMISSIONERS
416 North State Street
Jackson, Mississippi 39201

WATER WELL DRILLERS LOG

1979 BUTANE GAS COMPANY
OF GREENWOOD

Sunflower
county well located

4-2
date well completed

LANDOWNER:	description of formations encountered	from	to
CONWAY FARMS			
ITHA BEA (mailing address)	Clay	0	18
	Sand	18	60
	Sand & Gravel	60	100
WELL LOCATION:			
sec. 1 T ²² N R ⁴ E			
3 1/2 miles E of Drew			
(distance) (direction) (nearest town)			
WELL PURPOSE: Home (home, irrigation, municipal, industrial)			
WELL COMPLETION DATA:			
(1) diameter (inches) 4"			
(2) total depth (feet) 100			
(3) static water level (feet) 20 below top of ground.			
(4) casing PVC -80 (material) (depth)			
4" (size) if telescope see back.			
(5) screen 20 80 (length) (depth to top)			
4" PVC (size) (material)			
(6) pump 1 20 (HP) (yield gpm)			
Elec (type power)			
(7) electric log No (yes or no)			
(organization running log)			
(8) how well bottom plugged BACK PRESSURE VALVE			
DRILLERS REMARKS:			


Miss. Board of Water Comm.

APR 18 1979

RECEIVED

If well telescopes please sketch and show depths.

GROUND LEVEL

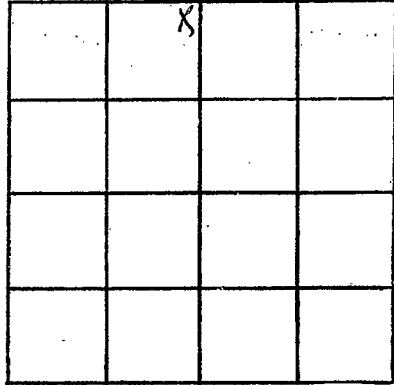

SECTION 1

Please indicate well location X.

ADDITIONAL INFORMATION

If more than one screen,
show locations of each on sketch.